


1 LOCATION OF WATER WELL:	Fraction	Section Number	Township Number	Range Number
County: <u>Harvey</u>	<u>NW 1/4 SW 1/4 SW 1/4</u>	<u>36</u>	T <u>23</u> S	R <u>1</u> EW

Distance and direction from nearest town or city street address of well if located within city?

1 mi. W, 1 S of Newton

2 WATER WELL OWNER:	Board of Agriculture, Division of Water Resources
RR#, St. Address, Box # :	Application Number:
City, State, ZIP Code :	

3 LOCATE WELL'S LOCATION WITH AN "X" IN SECTION BOX:	4 DEPTH OF COMPLETED WELL <u>43</u> ft. ELEVATION:
--	--

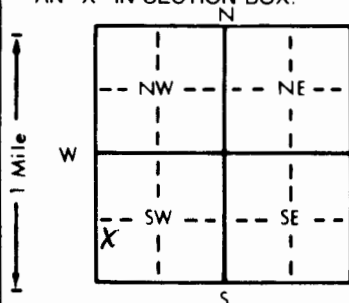

Depth(s) Groundwater Encountered	1	ft. 2	ft. 3	ft.
WELL'S STATIC WATER LEVEL	<u>16</u>	ft. below land surface measured on	mo/day/yr	<u>9-24-94</u>
Pump test data: Well water was	<u>28</u>	ft. after	<u>1</u>	hours pumping
Est. Yield	<u>25</u>	gpm		
Bore Hole Diameter	<u>8</u>	in. to	<u>43</u>	ft. and
WELL WATER TO BE USED AS:	5 Public water supply	8 Air conditioning	11 Injection well	
	2 Domestic	3 Feedlot	6 Oil field water supply	9 Dewatering
	2 Irrigation	4 Industrial	7 Lawn and garden only	10 Monitoring well
Was a chemical/bacteriological sample submitted to Department?	Yes	No	<u>X</u>	If yes, mo/day/yr sample was submitted
Water Well Disinfected?	Yes	No	<u>X</u>	

5 TYPE OF BLANK CASING USED:	5 Wrought iron	8 Concrete tile	CASING JOINTS: Glued <u>X</u> Clamped
1 Steel	3 RMP (SR)	6 Asbestos-Cement	9 Other (specify below)
2 PVC	4 ABS	7 Fiberglass	

Blank casing diameter	<u>5</u>	in. to	<u>33</u>	ft. Dia	<u>2.27</u>	in. to	<u>160</u>	lbs./ft. Wall thickness or gauge No.
Casing height above land surface	<u>24</u>	in.						

TYPE OF SCREEN OR PERFORATION MATERIAL:	1 Steel	3 Stainless steel	5 Fiberglass	8 RMP (SR)	10 Asbestos-cement
	2 Brass	4 Galvanized steel	6 Concrete tile	9 ABS	11 Other (specify)
					12 None used (open hole)

SCREEN OR PERFORATION OPENINGS ARE:	5 Gauzed wrapped	8 Saw cut	11 None (open hole)
1 Continuous slot	3 Mill slot	9 Drilled holes	
2 Louvered shutter	4 Key punched	10 Other (specify)	

SCREEN-PERFORATED INTERVALS:	From	<u>33</u>	ft. to	<u>43</u>	ft. From	ft. to	ft.
GRAVEL PACK INTERVALS:	From	<u>23</u>	ft. to	<u>43</u>	ft. From	ft. to	ft.

6 GROUT MATERIAL:	1 Neat cement	2 Cement grout	3 Bentonite	4 Other			
GROUT INTERVALS:	From	<u>3</u>	ft. to	<u>23</u>	ft. From	ft. to	ft.

What is the nearest source of possible contamination:	1 Septic tank	4 Lateral lines	7 Pit privy	10 Livestock pens	14 Abandoned water well
	2 Sewer lines	5 Cess pool	8 Sewage lagoon <u>proposed</u>	11 Fuel storage	15 Oil well/Gas well
	3 Watertight sewer lines	6 Seepage pit	9 Feedyard	12 Fertilizer storage	16 Other (specify below)

Direction from well?	<u>SE</u>	How many feet?	<u>100</u>
----------------------	-----------	----------------	------------

FROM	TO	LITHOLOGIC LOG	FROM	TO	PLUGGING INTERVALS
<u>0</u>	<u>15</u>	<u>Br Clay</u>			
<u>15</u>	<u>34</u>	<u>Br + Gr Clay</u>			
<u>34</u>	<u>38</u>	<u>Sand + Sm Gravel</u>			
<u>38</u>	<u>43</u>	<u>Gr Shale</u>			

7 CONTRACTOR'S OR LANDOWNER'S CERTIFICATION: This water well was <u>(1)</u> constructed, (2) reconstructed, or (3) plugged under my jurisdiction and was completed on (mo/day/year) <u>9-24-94</u> and this record is true to the best of my knowledge and belief. Kansas Water Well Contractor's License No. <u>447</u> This Water Well Record was completed on (mo/day/yr) <u>9-26-94</u> under the business name of <u>Miller Drilling</u> by (signature) <u>Eg Miller</u>
---