

|   |                                                                         |                                                  |                         |                                                                |
|---|-------------------------------------------------------------------------|--------------------------------------------------|-------------------------|----------------------------------------------------------------|
| LOCATION OF WATER WELL   | Fraction                                                                | Section Number                                   | Township Number         | Range Number                                                   |
| County: <u>Reno</u>   | <u>NE</u> $\frac{1}{4}$ <u>NE</u> $\frac{1}{4}$ <u>NE</u> $\frac{1}{4}$ | <u>1</u>                                         | <u>T 23</u> <u>S</u>    | <u>R 10</u> <u>NW</u>                                          |
| Distance and direction from nearest town or city?<br><u>1 1/2 mi W and 1 mi N of Huntsville</u>   |                                                                         | Street address of well if located within city?   |                         |                                                                |
| WATER WELL OWNER: <u>KGS/ GWMD*5</u>   |                                                                         |                                                  |                         |                                                                |
| RR#, St. Address, Box #   |                                                                         | Board of Agriculture, Division of Water Resource |                         |                                                                |
| City, State, ZIP Code   |                                                                         | Application Number: <u>NA</u>                    |                         |                                                                |
| DEPTH OF COMPLETED WELL: <u>195</u> ft. Bore Hole Diameter: <u>9 7/8</u> in. to <u>195</u> ft. and <u>195</u> ft. in. to <u>195</u> ft.   |                                                                         |                                                  |                         |                                                                |
| Well Water to be used as:   |                                                                         |                                                  |                         |                                                                |
| 5 Public water supply   |                                                                         | 8 Air conditioning                               |                         | 11 Injection well                                              |
| 1 Domestic   | 3 Feedlot                                                               | 6 Oil field water supply                         | 9 Dewatering            | 12 Other (Specify below)                                       |
| 2 Irrigation   | 4 Industrial                                                            | 7 Lawn and garden only                           | 10 Observation well     | <u>Research</u>                                                |
| Well's static water level: <u>18.4</u> ft. below land surface measured on <u>Jan</u> month <u>29</u> day <u>1983</u> year   |                                                                         |                                                  |                         |                                                                |
| Pump Test Data: <u>NA</u> Well water was <u>ft. after</u> hours pumping <u>gpm</u>   |                                                                         |                                                  |                         |                                                                |
| Est. Yield <u>gpm</u> Well water was <u>ft. after</u> hours pumping <u>gpm</u>   |                                                                         |                                                  |                         |                                                                |
| TYPE OF BLANK CASING USED:   |                                                                         |                                                  |                         |                                                                |
| 5 Wrought iron   |                                                                         | 8 Concrete tile                                  |                         | Casing Joints: <u>Glued</u> Clamped                            |
| 1 Steel   | 3 RMP (SR)                                                              | 6 Asbestos-Cement                                | 9 Other (specify below) | Welded                                                         |
| <u>2 PVC</u>   | 4 ABS                                                                   | 7 Fiberglass                                     |                         | Threaded                                                       |
| Blank casing dia <u>5"</u> in. to <u>190</u> ft. Dia <u>190</u> in. to <u>190</u> ft. Dia <u>190</u> in. to <u>190</u> ft. Dia <u>190</u> in. to <u>190</u> ft.   |                                                                         |                                                  |                         |                                                                |
| Casing height above land surface <u>in.</u> weight <u>lbs./ft.</u> Wall thickness or gauge No <u>Schd #40</u>   |                                                                         |                                                  |                         |                                                                |
| TYPE OF SCREEN OR PERFORATION MATERIAL:   |                                                                         |                                                  |                         |                                                                |
| 1 Steel   |                                                                         | 3 Stainless steel                                |                         | 5 Fiberglass                                                   |
| 2 Brass   | 4 Galvanized steel                                                      | 6 Concrete tile                                  | 9 ABS                   | 11 Other (specify)                                             |
| Screen or Perforation Openings Are:   |                                                                         | 5 Gauzed wrapped                                 |                         | 8 Saw cut                                                      |
| 1 Continuous slot   | <u>3 Mill slot</u>                                                      | 6 Wire wrapped                                   | 9 Drilled holes         | 11 None (open hole)                                            |
| 2 Louvered shutter   | 4 Key punched                                                           | 7 Torch cut                                      | 10 Other (specify)      |                                                                |
| Screen-Perforation Dia <u>5.0</u> in. to <u>190</u> ft. Dia <u>190</u> in. to <u>190</u> ft. Dia <u>190</u> in. to <u>190</u> ft. Dia <u>190</u> in. to <u>190</u> ft.   |                                                                         |                                                  |                         |                                                                |
| Screen-Perforated Intervals: From <u>190</u> ft. to <u>195</u> ft. |                                                                         |                                                  |                         |                                                                |
| Gravel Pack Intervals: From <u>185</u> ft. to <u>195</u> ft. |                                                                         |                                                  |                         |                                                                |
| GROUT MATERIAL: <u>1</u> Neat cement <u>2</u> Cement grout <u>3</u> Bentonite <u>4</u> Other   |                                                                         |                                                  |                         |                                                                |
| Grouted Intervals: From <u>7.9</u> ft. to <u>185</u> ft. From <u>0</u> ft. to <u>10</u> ft.   |                                                                         |                                                  |                         |                                                                |
| What is the nearest source of possible contamination: <u>NOT KNOWN</u>   |                                                                         |                                                  |                         |                                                                |
| 1 Septic tank   |                                                                         | 4 Cess pool                                      |                         | 7 Sewage lagoon                                                |
| 2 Sewer lines   | 5 Seepage pit                                                           | 8 Feed yard                                      | 11 Fertilizer storage   | 15 Oil well/Gas well                                           |
| 3 Lateral lines   | 6 Pit privy                                                             | 9 Livestock pens                                 | 12 Insecticide storage  | 16 Other (specify below)                                       |
| Direction from well   |                                                                         | How many feet                                    |                         | ? Water Well Disinfected? Yes <u>No</u>                        |
| Was a chemical/bacteriological sample submitted to Department? Yes <u>(No)</u> If yes, date sample submitted <u>month</u> <u>day</u> <u>year</u> Pump installed? Yes <u>(No)</u>   |                                                                         |                                                  |                         |                                                                |
| Yes: Pump Manufacturer's name   |                                                                         | Model No.                                        |                         | HP Volts                                                       |
| Depth of Pump Intake <u>ft.</u>   |                                                                         | Pumps Capacity rated at <u>gal./min.</u>         |                         |                                                                |
| Type of pump: 1 Submersible 2 Turbine 3 Jet 4 Centrifugal 5 Reciprocating 6 Other   |                                                                         |                                                  |                         |                                                                |
| CONTRACTOR'S OR LANDOWNER'S CERTIFICATION: This water well was (1) constructed, (2) reconstructed, or (3) plugged under my jurisdiction and was completed on <u>Aug</u> month <u>25</u> day <u>81</u> year   |                                                                         |                                                  |                         |                                                                |
| And this record is true to the best of my knowledge and belief. Kansas Water Well Contractor's License No. <u>1738</u>   |                                                                         |                                                  |                         |                                                                |
| His Water Well Record was completed on <u>1738</u> month <u>day</u> year under the business name of <u>by (signature)</u>   |                                                                         |                                                  |                         |                                                                |
| LOCATE WELL'S LOCATION WITH AN "X" IN SECTION BOX:   |                                                                         | LITHOLOGIC LOG                                   |                         |                                                                |
|   |                                                                         | FROM                                             | TO                      | LITHOLOGIC LOG                                                 |
|   |                                                                         | 0                                                | 2                       | brown silty top soil 1736                                      |
|   |                                                                         | 2                                                | 18                      | clay; brown, orange, gray, traces of sand and gravel 1720      |
|   |                                                                         | 18                                               | 22                      | sand and gravel 1716                                           |
|   |                                                                         | 22                                               | 46                      | clay; white, gray, light red, some is sandy 1692               |
|   |                                                                         | 46                                               | 92                      | sand / gravel, some clay zones and caliche zones 1646          |
|   |                                                                         | 92                                               | 120                     | clay, light red, with sand/gravel stringers 1618               |
|   |                                                                         | 120                                              | 145                     | clay, gray, sand lenses, caliche zones 1593                    |
|   |                                                                         | 145                                              | 150                     | sand and gravel 1588                                           |
|   |                                                                         | 150                                              | 172                     | clay, light red, sandy, traces of gravel and caliche zones 156 |
| 172   | 195                                                                     | red silt stone, green resistant inclusions       |                         |                                                                |
| ELEVATION: <u>1738.2</u>   |                                                                         |                                                  |                         |                                                                |
| Depth(s) Groundwater Encountered 1. <u>ft.</u> 2. <u>ft.</u> 3. <u>ft.</u> 4. <u>ft.</u> (Use a second sheet if needed)   |                                                                         |                                                  |                         |                                                                |
| INSTRUCTIONS: Use typewriter or ball point pen, please press firmly and PRINT clearly. Please fill in blanks, underline or circle the correct answers. Send top three copies to Kansas Department of Health and Environment, Division of Environment, Water Well Contractors, Topeka, KS 66620. Send one to WATER WELL OWNER and retain one for your records. |                                                                         |                                                  |                         |                                                                |

BIG BEND GMD#5-KGS  
WATER QUALITY  
OBSERVATION WELL  
NETWORK

SITE NUMBER : 26  
SITE LOCATION: NE NE NE


LEGAL LOCATION: 1-23-10W  
COUNTY : RENO

WELL LOG

| FROM | TO                 | LITHOLOGIC LOG                                                             | OWNER: SANKEY |
|------|--------------------|----------------------------------------------------------------------------|---------------|
| 0    | 2                  | silty topsoil                                                              |               |
| 2    | 4                  | brown & orange sandy and silty clay                                        |               |
| 4    | 8                  | gray silty & sandy clay; fine to medium sand                               |               |
| 8    | 10                 | same; orange stringers, trace fine gravel QA                               |               |
| 10   | 13                 | lt. gray clay, some silt & f. sand (quartz/arkosic) QA                     |               |
| 13   | 16                 | very light red, some sand                                                  |               |
| 16   | 18                 | orange silty clay with some fine QA sand                                   |               |
| 18   | 22                 | fine QA gravel, med & coarse QA sand                                       |               |
| 22   | 30                 | white & light red clay, med-coarse QA sand, gr. clay                       |               |
| 30   | 34                 | light red & light gray clay w/ fine QA sand                                |               |
| 34   | 46                 | same; some orange clay, fine sand QA, hard zone at 41', some gravel at 46' |               |
| 46   | 50                 | fine gravel & clay; med-coarse QA sand                                     |               |
| 50   | 65                 | fine to coarse QA sand, some clay, caliche zones                           |               |
| 65   | 80                 | same, mostly coarse sand QA, some gravel                                   |               |
| 80   | 92                 | same, caliche @ 90'; clay increasing toward bottom                         |               |
| 92   | 95                 | light red clay with fine QA gravel                                         |               |
| 95   | 105                | gravel & sand QA, some clay                                                |               |
| 105  | 110                | light red clay & fine QA sand, some caliche                                |               |
| 110  | 120                | gray & tan clay, fine QA sand; caliche @ 116.5'                            |               |
| 120  | 125                | dark gray clay with caliche zones                                          |               |
| 125  | 130                | same; traces of lt. red and tan clay                                       |               |
| 130  | 145                | clay with fine sand and gravel                                             |               |
| 145  | 150                | medium fine gravel and sand                                                |               |
| 150  | 160                | lt. red silty clay; some caliche zones & vf. QA sand                       |               |
| 160  | 165                | lt. red sandy clay; caliche zones;<br>thin sand & gravel lenses            |               |
| 165  | <del>175</del> 177 | red sandy clay                                                             |               |
| 177  | 180                | red sandy siltstone; redbed PERMIAN                                        |               |
| 180  | 195                | same with occasional greenish-gray inclusions                              |               |
|      |                    |                                                                            | (N)           |
|      |                    | 3                                                                          | 2             |
|      |                    | 60'/5'                                                                     | 118'/5'       |
|      |                    | TD=65'                                                                     | TD=123'       |
|      |                    |                                                                            | 1             |
|      |                    |                                                                            | 190'/5'       |
|      |                    |                                                                            | TD=195'       |

SITE NUMBER : 26  
SITE LOCATION : NE NE NE  
LEGAL LOCATION: SEC1 T23S R10W  
COUNTY : RENO

LANDOWNER: LARRY SANKEY  
ADDRESS : RURAL ROUTE 1  
STERLING, KANSAS 67579  
PHONE NO.: 316-278-2160

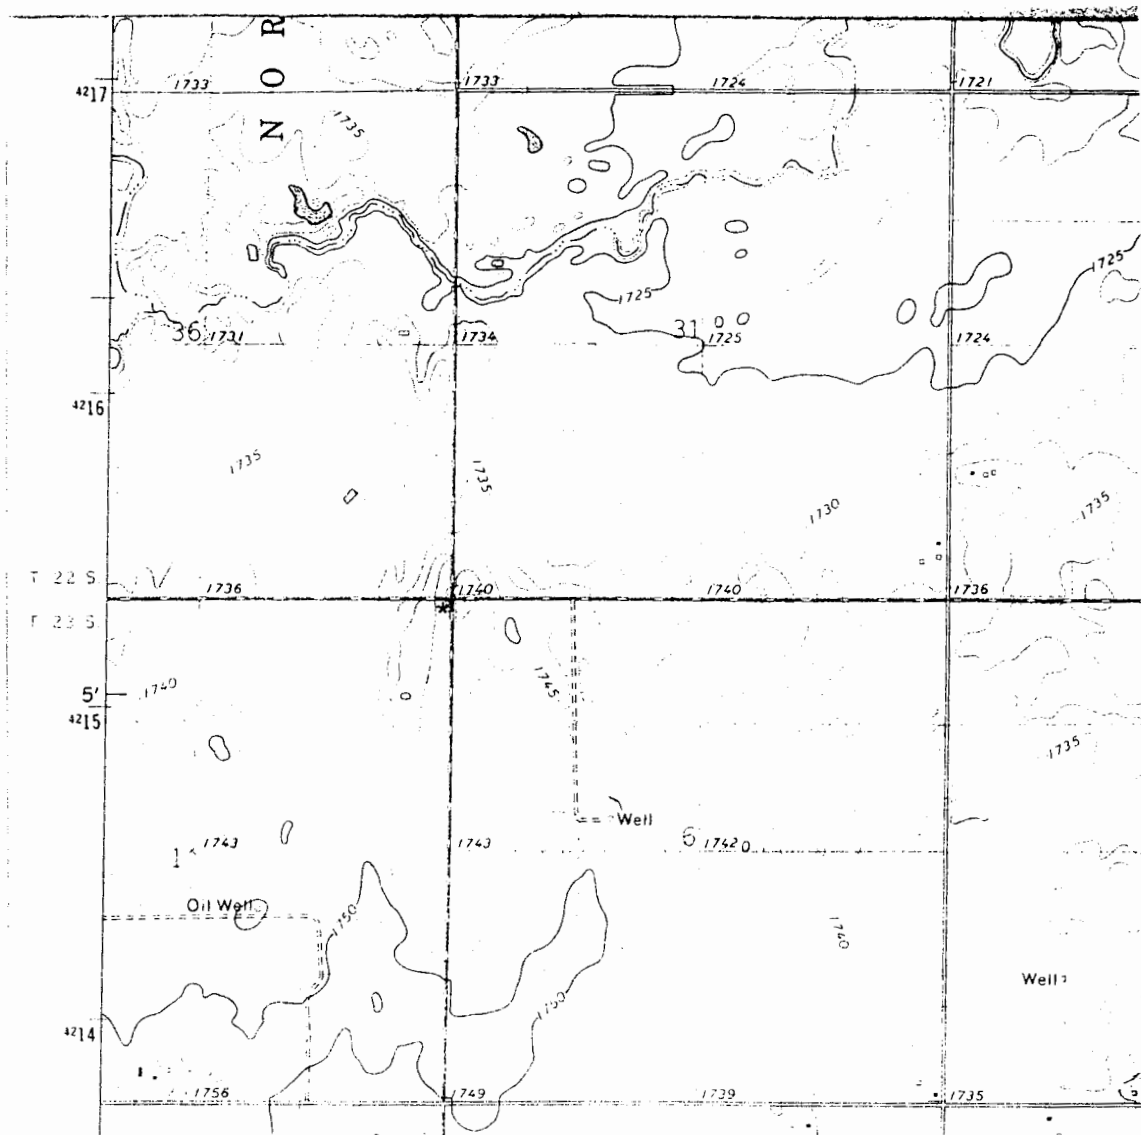

WELL LOCATION \*