

NE $\frac{1}{4}$ NW $\frac{1}{4}$ NW $\frac{1}{4}$

BIG BEND GMD#5-KGS
WATER QUALITY
OBSERVATION WELL
NETWORK

SITE NUMBER : 25
SITE LOCATION: NE NW NW


LEGAL LOCATION: 6-23-10W
COUNTY : RENO

WELL LOG

[illegible]

SITE NUMBER : 25
SITE LOCATION : NE NW NW
LEGAL LOCATION: SEC6 T23S R10W
COUNTY : RENO

LANDOWNER: WALTER "BUD" MILLER
ADDRESS : RURAL ROUTE 2
SYLVIA, KANSAS 67581
PHONE NO.: 316-486-2372

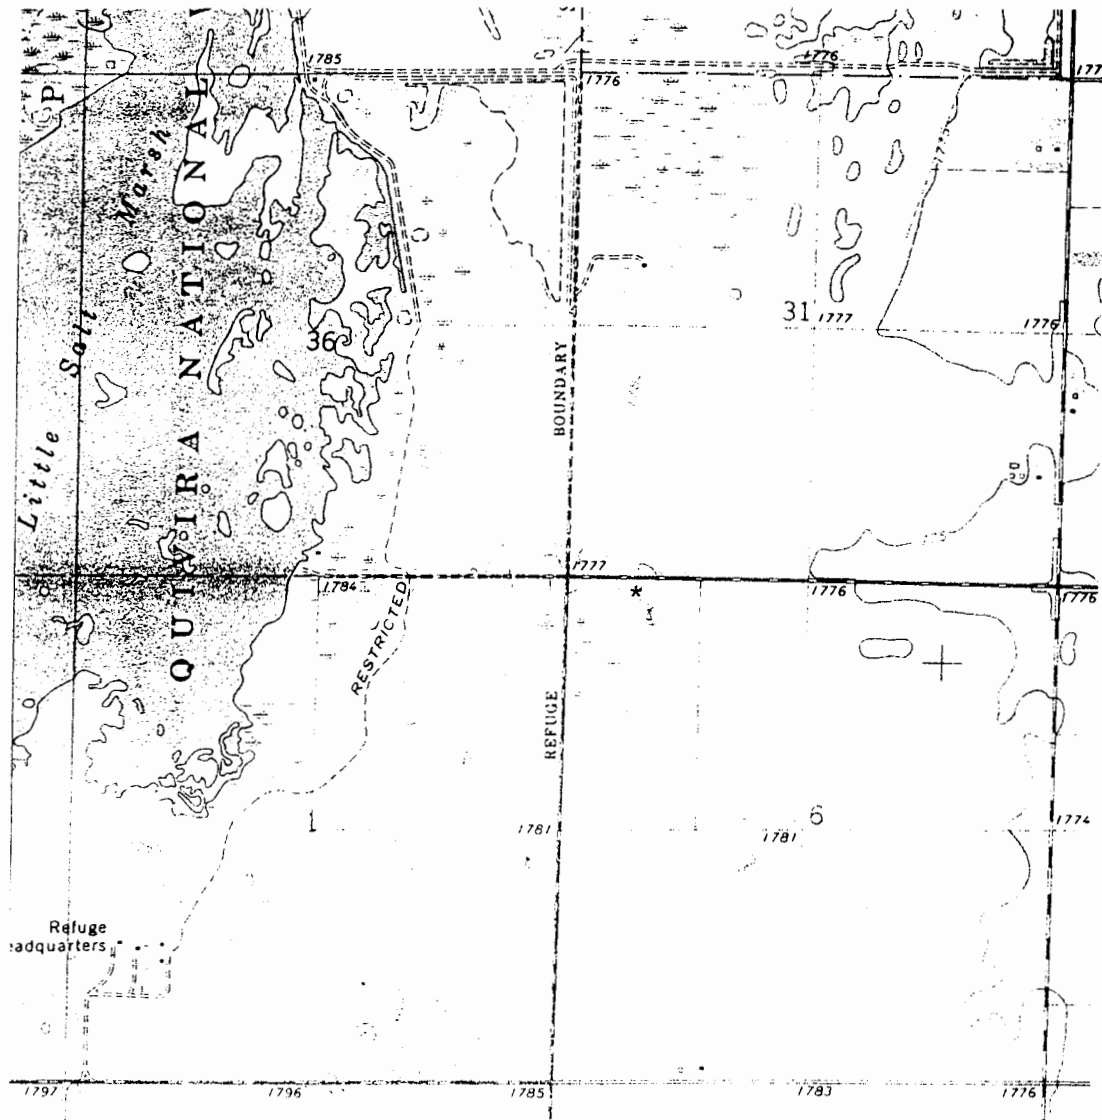

WELL LOCATION *