

WATER WELL PLUGGING RECORD Form WWC-5P

KSA 82a-1212

ID NO.

1 LOCATION OF WATER WELL: County: STAFFORD	Fraction NE ¼ SW ¼ SW ¼ ¼	Section Number 01	Township Number T 23 S	Range Number 11 ☐ E ☒ W
---	------------------------------	-----------------------------	----------------------------------	---

 Street/Rural Address of Well Location; if unknown, distance & direction from nearest town or intersection: If at owner's address, check here ☐
Global Positioning Systems (GPS) information:

 Latitude: **38.074565** (in decimal degrees)

 Longitude: **-98.488494** (in decimal degrees)

Elevation:

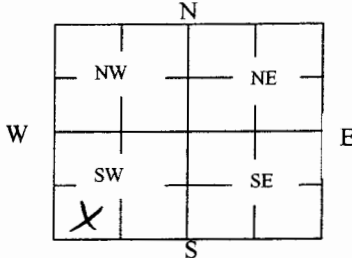
 Datum: ☐ WGS84, ☐ NAD83, ☐ NAD27

Collection Method:
☒ GPS unit (Make/Model: **MAGELLAN**)

☐ Digital Map/Photo, ☐ Topographic Map, ☐ Land Survey

 Est. Accuracy: ☐ < 3 m. ☐ 3-5 m. ☐ 5-15 m. ☐ > 15 m

2 WATER WELL OWNER: **Quivira Wildlife Refuge**
 RR#, St. Address, Box #: **1434 NE 80th St**
 City, State ZIP Code: **Stafford, KS 67578**

3 MARK WELL'S LOCATION WITH AN "X" IN SECTION BOX:

4 DEPTH OF WELL 300 **ft.**

 WELL'S STATIC WATER LEVEL N/A **ft**
WELL WAS USED AS:
☐ Domestic
☐ Irrigation
☐ Feedlot
☐ Industrial

☐ Public Water Supply
☐ Oil Field Water Supply
☐ Domestic (Lawn & Garden)
☐ Air Conditioning

☐ Dewatering
☐ Monitoring
☐ Injection Well
☒ Other Geothermal

 Was a chemical/bacteriological sample submitted to Department? Yes ☐ No ☒
5 TYPE OF BLANK CASING USED:
☐ Steel
☐ PVC

☐ RMP (SR)
☐ ABS

☐ Wrought
☐ Asbestos-Cement

☐ Fiberglass
☐ Concrete Tile

☒ Other (Specify below)
N/A

 Blank casing diameter _____ in. Was casing pulled? Yes ☐ No ☐ If yes, how much _____
 Casing height above or below land surface _____ in.

6 GROUT PLUG MATERIAL: ☐ Neat cement ☐ Cement grout ☒ Bentonite ☐ Other _____

 Grout Plug Intervals: From 0 ft. to 300 ft., From _____ ft. to _____ ft., From _____ to _____ ft.

What is the nearest source of possible contamination:

☐ Septic tank
☐ Sewer lines
☐ Watertight sewer lines
☐ Lateral lines
☐ Cess pool

☐ Seepage pit
☐ Pit privy
☐ Sewage lagoon
☐ Feedyard
☐ Livestock pens

☐ Fuel Storage
☐ Fertilizer storage
☐ Insecticide storage
☐ Abandoned water well
☐ Oil well/Gas well

☒ Other (specify below)
BUILDING

 Direction from well? SOUTH EAST

 How many feet? 80 FEET

FROM	TO	PLUGGING MATERIALS	FROM	TO	PLUGGING MATERIALS
0	10	RED SAND			
10	25	RED CLAY			
25	40	SAND			
40	90	YELLOW CLAY			
90	130	SAND & GRAVEL			
130	300	RED SHALE			

7 CONTRACTOR'S OR LANDOWNER'S CERTIFICATION: This water well was plugged under my jurisdiction and was completed on (mo/day/year) 7/16/10 and this record is true to the best of my knowledge and belief. Kansas Water Well Contractor's License No. 812. This Water Well Record was completed on (mo/day/year) 7/13/10 under the business name of ENVIRONMENTAL LOOP SERVICE, INC by (signature) Richard Moore

INSTRUCTIONS: Use typewriter or ballpoint pen. Please press firmly and print clearly. Please fill in blanks, underline or circle the correct answers. Send top three copies to Kansas Department of Health and Environment, Bureau of Water, Geology Section, 1000 SW Jackson St., Ste. 420, Topeka, Kansas 66612-1367. Telephone: 785/296-5524. Send one to Water Well Owner and retain one for your records. Visit us at <http://www.kdheks.gov/waterwell/index.html>.

Check one:

☒ White Copy ☐ Blue Copy ☐ Pink Copy