WATER WELL RECORD Form WWC-5 KSA 82a-1212 ID No. _____

1 LOCATION OF WATER WELL:	Fraction	Section Number	Township Number	Range Number
County: Stafford	SW ¼ SW ¼ SW ¼	12	T 23 S	R 12 E/W

Distance and direction from nearest town or city street address of well if located within city?
3 south, 3¼ east of Hudson

2 WATER WELL OWNER: Joe Fritzemeyer
RR#, St. Address, Box # : 408 E. Camden
City, State, ZIP Code : Stafford, Ks. 67578

Board of Agriculture, Division of Water Resources
Application Number: SFWW1740

3 LOCATE WELL'S LOCATION WITH AN "X" IN SECTION BOX:

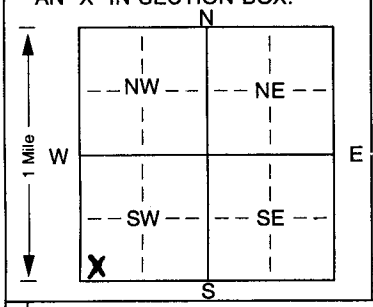

4 DEPTH OF COMPLETED WELL....60..... ft. ELEVATION:.....
Depth(s) Groundwater Encountered 1..... ft. 2..... ft. 3..... ft.
WELL'S STATIC WATER LEVEL...24..... ft. below land surface measured on mo/day/yr .....
Pump test data: Well water was ..... ft. after ..... hours pumping ..... gpm
Est. Yield ....NA...gpm: Well water was ..... ft. after ..... hours pumping ..... gpm
Bore Hole Diameter...8½..... in. to .....60..... ft., and..... in. to ..... ft.
WELL WATER TO BE USED AS: 5 Public water supply 8 Air conditioning 11 Injection well
1 Domestic 3 Feedlot 6 Oil field water supply 9 Dewatering 12 Other (Specify below)
2 Irrigation 4 Industrial 7 Domestic (lawn & garden) 10 Monitoring well ....stock.....
Was a chemical/bacteriological sample submitted to Department? Yes..... No...X..; If yes, mo/day/yrs sample was submitted
Water Well Disinfected? Yes HTH No

5 TYPE OF BLANK CASING USED: 5 Wrought iron 8 Concrete tile CASING JOINTS: Glued...X... Clamped.....
1 Steel 3 RMP (SR) 6 Asbestos-Cement 9 Other (specify below) Welded.....
2 PVC 4 ABS 7 Fiberglass ..... Threaded.....
Blank casing diameter.....5.....in. to.....48.....ft., Dia.....in. to.....ft., Dia.....in. to.....ft.
Casing height above land surface.....18..... in., weight....SDR-26..... lbs./ft. Wall thickness or gauge No.....
TYPE OF SCREEN OR PERFORATION MATERIAL: 7 PVC 10 Asbestos-cement
1 Steel 3 Stainless steel 5 Fiberglass 8 RMP (SR) 11 Other (specify).....
2 Brass 4 Galvanized steel 6 Concrete tile 9 ABS 12 None used (open hole)
SCREEN OR PERFORATION OPENINGS ARE: 5 Gauzed wrapped 8 Saw cut 11 None (open hole)
1 Continuous slot 3 Mill slot 6 Wire wrapped 9 Drilled holes
2 Louvered shutter 4 Key punched 7 Torch cut 10 Other (specify).....ft.
SCREEN-PERFORATED INTERVALS: From.....48..... ft. to.....60..... ft., From..... ft. to..... ft.
From..... ft. to..... ft., From..... ft. to..... ft.
GRAVEL PACK INTERVALS: From.....20..... ft. to.....60..... ft., From..... ft. to..... ft.
From..... ft. to..... ft., From..... ft. to..... ft.

6 GROUT MATERIAL: 1 Neat cement 2 Cement grout 3 Bentonite 4 Other...hole plug.....
Grout Intervals: From.....20..... ft. to.....0..... ft., From..... ft. to..... ft., From..... ft. to..... ft.
What is the nearest source of possible contamination: 10 Livestock pens 14 Abandoned water well
1 Septic tank 4 Lateral lines 7 Pit privy 11 Fuel storage 15 Oil well/Gas well
2 Sewer lines 5 Cess pool 8 Sewage lagoon 12 Fertilizer storage 16 Other (specify below)
3 Watertight sewer lines 6 Seepage pit 9 Feedyard 13 Insecticide storage .....
Direction from well? north How many feet? 50

FROM	TO	LITHOLOGIC LOG	FROM	TO	PLUGGING INTERVALS
0	3	Top soil			
3	22	Brown clay			
22	42	Brown & gray sandy clay			
42	45	Blue, gray clay & fine sand			
45	60	Sand & gravel clean, loose, medium			

7 CONTRACTOR'S OR LANDOWNER'S CERTIFICATION: This water well was (1) constructed, (2) reconstructed, or (3) plugged under my jurisdiction and was completed on (mo/day/year)...11-3-00..... and this record is true to the best of my knowledge and belief. Kansas Water Well Contractor's Licence No....134..... This Water Well Record was completed on (mo/day/yr) 11-8-00.....
under the business name of Rosencrantz-Bemis by (signature) Fredia Dodson

INSTRUCTIONS: Use typewriter or ball point pen. *PLEASE PRESS FIRMLY* and *PRINT* clearly. Please fill in blanks, underline or circle the correct answers. Send top three copies to Kansas Department of Health and Environment, Bureau of Water, Topeka, Kansas 66620-0001. Telephone 785-296-5524. Send one to WATER WELL OWNER and retain one for your records. Fee of $5.00 for each constructed well.