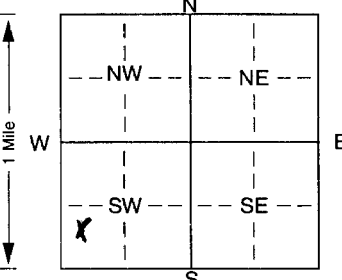


1 LOCATION OF WATER WELL: Fraction NW 1/4 SW 1/4 SW 1/4 Section Number 35 Township Number T 23 S Range Number R 12 EW  
 County: Stafford

Distance and direction from nearest town or city street address of well if located within city?  
 2 1/2 north, 1/2 west of Stafford, Ks.

2 WATER WELL OWNER: Leonard A. Fiscus  
 RR#, St. Address, Box # : Rt. 3 Box 47 Board of Agriculture, Division of Water Resources  
 City, State, ZIP Code : Stafford, Ks. 67578 Application Number: SFWM1817

3 LOCATE WELL'S LOCATION WITH AN "X" IN SECTION BOX:  
  
 4 DEPTH OF COMPLETED WELL: 60 ft. ELEVATION:  
 Depth(s) Groundwater Encountered 1. . . . . ft. 2. . . . . ft. 3. . . . . ft.  
 WELL'S STATIC WATER LEVEL . . . . . 8 . . . . . ft. below land surface measured on mo/day/yr . . . . . 5-8-01 . . . . .  
 Pump test data: Well water was . . . . . ft. after . . . . . hours pumping . . . . . gpm  
 Est. Yield . . . . . NA . . . . . gpm; Well water was . . . . . ft. after . . . . . hours pumping . . . . . gpm  
 Bore Hole Diameter . . . . . 9 7/8 . . . . . in. to . . . . . 65 . . . . . ft., and . . . . . in. to . . . . . ft.  
 WELL WATER TO BE USED AS:  
 1 Domestic 2 Irrigation 3 Feedlot 4 Industrial 5 Public water supply 6 Oil field water supply 7 Domestic (lawn & garden) 8 Air conditioning 9 Dewatering 10 Monitoring well 11 injection well 12 Other (Specify below)  
 Was a chemical/bacteriological sample submitted to Department? Yes. . . . . No. . . . . X . . . . . ; If yes, mo/day/yr sample was submitted  
 Water Well Disinfected? Yes . . . . . No . . . . . X . . . . .

5 TYPE OF BLANK CASING USED:  
 1 Steel 2 PVC 3 RMP (SR) 4 ABS 5 Wrought iron 6 Asbestos-Cement 7 Fiberglass 8 Concrete tile 9 Other (specify below) CASING JOINTS: Glued. . . . . X . . . . . Clamped. . . . .  
 Blank casing diameter . . . . . 9 7/8 . . . . . in. to . . . . . 40 . . . . . ft., Dia . . . . . in. to . . . . . ft., Dia . . . . . in. to . . . . . ft.  
 Casing height above land surface . . . . . 2 . . . . . in., weight . . . . . SDR-26 . . . . . lbs./ft. Wall thickness or gauge No. . . . .  
 TYPE OF SCREEN OR PERFORATION MATERIAL:  
 1 Steel 2 Brass 3 Stainless steel 4 Galvanized steel 5 Fiberglass 6 Concrete tile 7 PVC 8 RMP (SR) 9 ABS 10 Asbestos-cement 11 Other (specify) . . . . . 12 None used (open hole)  
 SCREEN OR PERFORATION OPENINGS ARE:  
 1 Continuous slot 2 Louvered shutter 3 Mill slot 4 Key punched 5 Gauzed wrapped 6 Wire wrapped 7 Torch cut 8 Saw cut 9 ~~Drilled~~ holes 10 Other (specify) . . . . . ft. 11 None (open hole)  
 SCREEN-PERFORATED INTERVALS: From . . . . . 60 . . . . . ft. to . . . . . 40 . . . . . ft., From . . . . . ft. to . . . . . ft., From . . . . . ft. to . . . . . ft.  
 GRAVEL PACK INTERVALS: From . . . . . 65 . . . . . ft. to . . . . . 8 . . . . . ft., From . . . . . ft. to . . . . . ft., From . . . . . ft. to . . . . . ft.

6 GROUT MATERIAL: 1 Neat cement 2 Cement grout 3 Bentonite 4 Other . . . . . hole plug . . . . .  
 Grout Intervals: From . . . . . 8 . . . . . ft. to . . . . . 0 . . . . . ft., From . . . . . ft. to . . . . . ft., From . . . . . ft. to . . . . . ft.  
 What is the nearest source of possible contamination:  
 1 Septic tank 2 Sewer lines 3 Watertight sewer lines 4 Lateral lines 5 Cess pool 6 Seepage pit 7 Pit privy 8 Sewage lagoon 9 Feedyard 10 Livestock pens 11 Fuel storage 12 Fertilizer storage 13 Insecticide storage 14 Abandoned water well 15 Oil well/Gas well 16 Other (specify below) . . . . . NONE . . . . .  
 Direction from well? . . . . . How many feet? . . . . .

FROM	TO	LITHOLOGIC LOG	FROM	TO	PLUGGING INTERVALS
0	2	Top soil			
2	4	Gray clay			
4	18	Brown gray & white clay			
18	33	Clay & fine sand mix			
33	47	Sand & gravel medium, clean, loose			
47	49	White clay			
49	64	Sand & gravel medium, clean, loose			
64	65	White clay			

7 CONTRACTOR'S OR LANDOWNER'S CERTIFICATION: This water well was (1) constructed, (2) reconstructed, or (3) plugged under my jurisdiction and was completed on (mo/day/year) . . . . . 5-8-01 . . . . . and this record is true to the best of my knowledge and belief. Kansas Water Well Contractor's Licence No. . . . . 134 . . . . . This Water Well Record was completed on (mo/day/yr) . . . . . 5-15-01 . . . . .  
 under the business name of Rosencrantz-Bemis by (signature) *Judith Hodson*