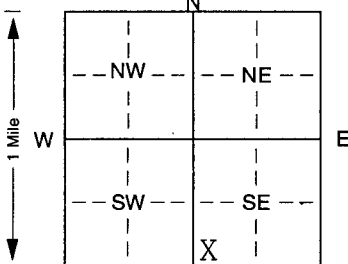


1 LOCATION OF WATER WELL:		Fraction		Section Number		Township Number		Range Number	
County: <u>Stafford</u>		SW ¼ SW ¼ SE ¼		<u>18</u>		T <u>23</u> S		R <u>12</u> <u>XW</u>	
Distance and direction from nearest town or city street address of well if located within city? <u>4 south, 1 1/8 west of Hudson, KS</u>									
2 WATER WELL OWNER: <u>Keith Miller</u>									
RR#, St. Address, Box # : <u>363 NE 80 Ave</u>					Board of Agriculture, Division of Water Resources				
City, State, ZIP Code : <u>Great Bend, KS 67530</u>					Application Number: <u>SFWW1967</u>				
3 LOCATE WELL'S LOCATION WITH		4 DEPTH OF COMPLETED WELL: <u>49</u> ft. ELEVATION:							
AN "X" IN SECTION BOX:		Depth(s) Groundwater Encountered 1. <u>1</u> ft. 2. <u>1</u> ft. 3. <u>1</u> ft.							
		WELL'S STATIC WATER LEVEL <u>18</u> ft. below land surface measured on mo/day/yr <u>9-21-01</u>							
		Pump test data: Well water was <u>NA</u> ft. after <u>NA</u> hours pumping <u>NA</u> gpm							
		Est. Yield <u>NA</u> gpm: Well water was <u>NA</u> ft. after <u>NA</u> hours pumping <u>NA</u> gpm							
		Bore Hole Diameter <u>9 7/8</u> in. to <u>50</u> ft., and <u>NA</u> in. to <u>NA</u> ft.							
WELL WATER TO BE USED AS: 5 Public water supply 8 Air conditioning 11 Injection well									
1 Domestic 3 Feedlot 6 Oil field water supply 9 Dewatering 12 Other (Specify below)									
2 Irrigation 4 Industrial 7 Domestic (lawn & garden) 10 Monitoring well <u>Livestock</u>									
Was a chemical/bacteriological sample submitted to Department? Yes. <u>NA</u> No. <u>X</u> ; If yes, mo/day/yrs sample was submitted <u>NA</u>									
Water Well Disinfected? Yes <u>NA</u> No <u>X</u>									
5 TYPE OF BLANK CASING USED:									
1 Steel 3 RMP (SR) 5 Wrought iron 8 Concrete tile CASING JOINTS: Glued. <u>X</u> Clamped. <u>NA</u>									
2 PVC 4 ABS 6 Asbestos-Cement 9 Other (specify below) Welded. <u>NA</u>									
7 Fiberglass Threaded. <u>NA</u>									
Blank casing diameter <u>5</u> in. to <u>37</u> ft., Dia <u>NA</u> in. to <u>NA</u> ft., Dia <u>NA</u> in. to <u>NA</u> ft.									
Casing height above land surface <u>24</u> in., weight <u>SDR-26</u> lbs./ft. Wall thickness or gauge No. <u>NA</u>									
TYPE OF SCREEN OR PERFORATION MATERIAL:									
1 Steel 3 Stainless steel 5 Fiberglass 7 PVC 10 Asbestos-cement									
2 Brass 4 Galvanized steel 6 Concrete tile 8 RMP (SR) 11 Other (specify) <u>NA</u>									
9 ABS 12 None used (open hole)									
SCREEN OR PERFORATION OPENINGS ARE:									
1 Continuous slot 3 Mill slot 5 Gauzed wrapped 8 Saw cut 11 None (open hole)									
2 Louvered shutter 4 Key punched 6 Wire wrapped 9 Drilled holes									
7 Torch cut 10 Other (specify) <u>NA</u> ft.									
SCREEN-PERFORATED INTERVALS: From <u>37</u> ft. to <u>47</u> ft., From <u>NA</u> ft. to <u>NA</u> ft.									
From <u>NA</u> ft. to <u>NA</u> ft., From <u>NA</u> ft. to <u>NA</u> ft.									
GRAVEL PACK INTERVALS: From <u>50</u> ft. to <u>20</u> ft., From <u>NA</u> ft. to <u>NA</u> ft.									
From <u>NA</u> ft. to <u>NA</u> ft., From <u>NA</u> ft. to <u>NA</u> ft.									
6 GROUT MATERIAL: 1 Neat cement 2 Cement grout 3 Bentonite 4 Other <u>hole plug</u>									
Grout Intervals: From <u>20</u> ft. to <u>0</u> ft., From <u>NA</u> ft. to <u>NA</u> ft., From <u>NA</u> ft. to <u>NA</u> ft.									
What is the nearest source of possible contamination:									
1 Septic tank 4 Lateral lines 7 Pit privy 10 Livestock pens 14 Abandoned water well									
2 Sewer lines 5 Cess pool 8 Sewage lagoon 11 Fuel storage 15 Oil well/Gas well									
3 Watertight sewer lines 6 Seepage pit 9 Feedyard 12 Fertilizer storage 16 Other (specify below)									
13 Insecticide storage <u>None</u>									
Direction from well? <u>NA</u> How many feet? <u>NA</u>									
FROM TO LITHOLOGIC LOG FROM TO PLUGGING INTERVALS									
0 3 sandy top soil									
3 12 sandy brown clay									
12 16 brown and white clay									
16 21 sandy brown and white white clay									
21 34 sand and gravel small, clean, loose, few clay streaks									
34 50 sand and gravel medium, clean and loose									
7 CONTRACTOR'S OR LANDOWNER'S CERTIFICATION: This water well was (1) <u>constructed</u> , (2) reconstructed, or (3) plugged under my jurisdiction and was completed on (mo/day/year) <u>9-21-01</u> and this record is true to the best of my knowledge and belief. Kansas									
Water Well Contractor's Licence No. <u>134</u> This Water Well Record was completed on (mo/day/yr) <u>10-1-01</u>									
under the business name of <u>Rosencrantz-Bemis</u> by (signature) <u>John J. Bemis</u>									