

WATER WELL RECORD

Form WWC-5


Division of Water Resources App. No.

20160019

1 LOCATION OF WATER WELL: County: Stafford Fraction 1/4 NW 1/4 SW 1/4 NW 1/4 Section Number 21 Township No. T 23 S Range Number R 12 [] E [x] W

Street/Rural Address of Well Location; if unknown, distance & direction from nearest town or intersection: If at owner's address, check here []. 4 1/4 South of Hudson Global Positioning System (GPS) information: Latitude: .38.03841 (in decimal degrees) Longitude: 098.65430 (in decimal degrees) Elevation: Datum: [] WGS 84, [x] NAD 83, [] NAD 27 Collection Method: [x] GPS unit (Make/Model:) [] Digital Map/Photo, [] Topographic Map, [] Land Survey Est. Accuracy: [] <3 m, [] 3-5 m, [] 5-15 m, [] >15 m

2 WATER WELL OWNER: Griffin Management LLC RR#, Street Address, Box #: PO Box 347 City, State, ZIP Code : Pratt, KS 67124

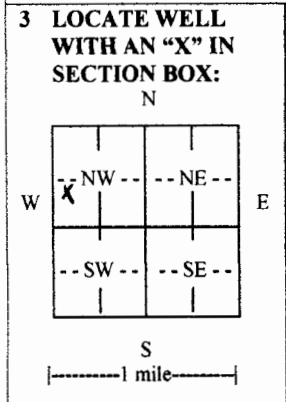

3 LOCATE WELL WITH AN "X" IN SECTION BOX: 4 DEPTH OF COMPLETED WELL 80 ft. Depth(s) Groundwater Encountered (1)..... ft. (2)..... ft. (3)..... ft. WELL'S STATIC WATER LEVEL 21 ft. below land surface measured on mo/day/yr. 2-4-16 Pump test data: Well water was..... ft. after..... hours pumping..... gpm EST. YIELD N/A... gpm. Well water was..... ft. after..... hours pumping..... gpm Bore Hole Diameter 10..... in. to .80..... ft., and in. to ft. WELL WATER TO BE USED AS: [] Public water supply [] Geothermal [] Injection well [] Domestic [] Feedlot [x] Oil field water supply [] Dewatering [] Other (Specify below) [] Irrigation [] Industrial [] Domestic-lawn & garden [] Monitoring well Was a chemical/bacteriological sample submitted to Department? [] Yes [x] No If yes, mo/day/yr sample was submitted..... Water well disinfected? [x] Yes [] No

5 TYPE OF CASING USED: [] Steel [x] PVC [] Other CASING JOINTS: [x] Glued [] Clamped [] Welded [] Threaded Casing diameter .5..... in. to .80..... ft., Diameter in. to ft., Diameter in. to ft. Casing height above land surface .18..... in., Weight SDR 26..... lbs./ft., Wall thickness or gauge No. TYPE OF SCREEN OR PERFORATION MATERIAL: [] Steel [] Stainless Steel [x] PVC [] Other (Specify) [] Brass [] Galvanized Steel [] None used (open hole) SCREEN OR PERFORATION OPENINGS ARE: [] Continuous slot [] Mill slot [] Gauze wrapped [] Torch cut [] Drilled holes [] None (open hole) [] Louvered shutter [] Key punched [] Wire wrapped [x] Saw cut [] Other (specify) SCREEN-PERFORATED INTERVALS: From 80..... ft. to 60..... ft., From ft. to ft. GRAVEL PACK INTERVALS: From 80..... ft. to 20..... ft., From ft. to ft.

6 GROUT MATERIAL: [] Neat cement [] Cement grout [x] Bentonite [] Other Grout Intervals: From ft. to ft., From 20..... ft. to 0..... ft., From ft. to ft. What is the nearest source of possible contamination: [] Septic tank [] Lateral lines [] Pit privy [] Livestock pens [] Insecticide storage [x] Other (specify below) [] Sewer lines [] Cesspool [] Sewage lagoon [] Fuel storage [] Abandoned water well [] Watertight sewer lines [] Seepage pit [] Feedyard [] Fertilizer storage [] Oil well/gas well None Direction from well Distance from well

FROM	TO	LITHOLOGIC LOG	FROM	TO	LITHO. LOG (cont.) or PLUGGING INTERVALS
0	2	Sandy top soil			
2	28	Sandy gray clay			
28	39	Sand & gravel			
39	58	Tan clay			
58	69	Sand & gravel- fine to small			
69	71	Tan clay & caliche			
71	79	Sand & gravel- small			
79	80	Clay			

7 CONTRACTOR'S OR LANDOWNER'S CERTIFICATION: This water well was [x] constructed, [] reconstructed, or [] plugged under my jurisdiction and was completed on (mo/day/year) 2-4-16..... and this record is true to the best of my knowledge and belief. Kansas Water Well Contractor's License No. 134..... This Water Well Record was completed on (mo/day/year) 2-5-16..... under the business name of Rosencrantz- Bemis Ent Inc..... by (signature) Sara Alford.....

INSTRUCTIONS: Use typewriter or ball point pen. PLEASE PRESS FIRMLY and PRINT clearly. Please fill in blanks and check the correct answers. Send one copy to Kansas Department of Health and Environment, Bureau of Water, Geology Section, 1000 SW Jackson St., Suite 420, Topeka, Kansas 66612-1367. Telephone 785-296-5524. Send one copy to WATER WELL OWNER and retain one for your records. Include fee of \$5.00 for each constructed well. Visit us at http://www.kdheks.gov/waterwell/index.html