

ISOC-2


WATER WELL PLUGGING RECORD Form WWC-5P KSA 82a-1212 ID NO.

1 LOCATION OF WATER WELL: Fraction 1/4 SW 1/4 SE 1/4 NW 1/4 Section Number 2 Township Number T 23 S Range Number 12 [ ] E [x] W

Street/Rural Address of Well Location; if unknown, distance & direction from nearest town or intersection: If at owner's address, check here [ ] North of Stafford, KS on N. Strafford Rd for 7 Miles, west 1 mile, 1/2 mile north.

Global Positioning Systems (GPS) information: Latitude: 38.07917 Longitude: 98.61450 Datum: [x] WGS84, [ ] NAD83, [ ] NAD27 Collection Method: [x] GPS unit (Make/Model: Garmin 60C) [ ] Digital Map/Photo, [ ] Topographic Map, [ ] Land Survey Est. Accuracy: [ ] < 3 m, [x] 3-5 m, [ ] 5-15 m, [ ] > 15 m

2 WATER WELL OWNER: Magellan Midstream Partners RR#, St. Address, Box #: One Williams Ctr, MD 27 City, State ZIP Code: Tulsa, OK 74172

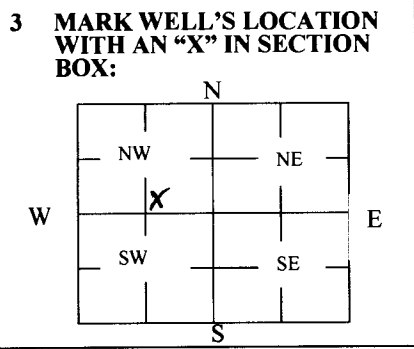

4 DEPTH OF WELL 18 ft. WELL'S STATIC WATER LEVEL \_\_\_\_\_ ft. WELL WAS USED AS: [ ] Domestic [ ] Irrigation [ ] Feedlot [ ] Industrial [ ] Public Water Supply [ ] Oil Field Water Supply [ ] Domestic (Lawn & Garden) [ ] Air Conditioning [ ] Dewatering [x] Monitoring [ ] Injection Well [ ] Other \_\_\_\_\_ Was a chemical/bacteriological sample submitted to Department? Yes [ ] No [x]

5 TYPE OF BLANK CASING USED: [ ] Steel [x] PVC [ ] RMP (SR) [ ] ABS [ ] Wrought [ ] Asbestos-Cement [ ] Fiberglass [ ] Concrete Tile [ ] Other (Specify below) \_\_\_\_\_ Blank casing diameter 2 in. Was casing pulled? Yes [x] No [ ] If yes, how much 8 feet Casing height above or below land surface 36 in.

6 GROUT PLUG MATERIAL: [ ] Neat cement [ ] Cement grout [x] Bentonite [ ] Other \_\_\_\_\_ Grout Plug Intervals: From 18 ft. to 2 ft., From \_\_\_\_\_ ft. to \_\_\_\_\_ ft., From \_\_\_\_\_ to \_\_\_\_\_ ft. What is the nearest source of possible contamination: [ ] Septic tank [ ] Sewer lines [ ] Watertight sewer lines [ ] Lateral lines [ ] Cess pool [ ] Seepage pit [ ] Pit privy [ ] Sewage lagoon [ ] Feedyard [ ] Livestock pens [ ] Fuel Storage [ ] Fertilizer storage [ ] Insecticide storage [ ] Abandoned water well [ ] Oil well/Gas well [x] Other (specify below) Pipeline Release Direction from well? \_\_\_\_\_ How many feet? \_\_\_\_\_

FROM	TO	PLUGGING MATERIALS	FROM	TO	PLUGGING MATERIALS
18	2	High Solids Bentonite			ISOC-2
2	0	Topsoil			

7 CONTRACTOR'S OR LANDOWNER'S CERTIFICATION: This water well was plugged under my jurisdiction and was completed on (mo/day/year) 11/28/2017 and this record is true to the best of my knowledge and belief. Kansas Water Well Contractor's License No. 710. This Water Well Record was completed on (mo/day/year) 12/1/2017 under the business name of Below Ground Surface, Inc. by (signature)

INSTRUCTIONS: Use typewriter or ballpoint pen. Please press firmly and print clearly. Please fill in blanks, underline or circle the correct answers. Send top three copies to Kansas Department of Health and Environment, Bureau of Water, Geology Section, 1000 SW Jackson St., Ste. 420, Topeka, Kansas 66612-1367. Telephone: 785/296-5524. Send one to Water Well Owner and retain one for your records. Visit us at http://www.kdheks.gov/waterwell/index.html.

Check one: [ ] White Copy [ ] Blue Copy [ ] Pink Copy