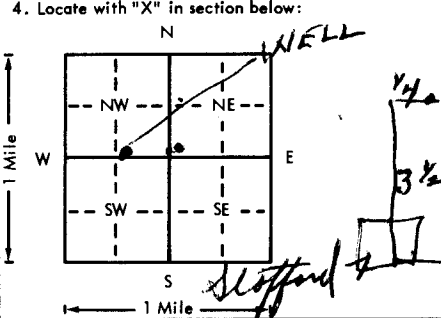


USE TYPEWRITER OR BALL
POINT PEN-PRESS FIRMLY,
PRINT CLEARLY.

WATER WELL RECORD
KSA 82a-1201-1215

Kansas Department of Health and
Environment-Division of Environment
(Water well Contractors)
Topeka, Kansas 66620

1. Location of well: County <u>Stafford</u> Fraction <u>SW 1/4 SE 1/4 NW 1/4</u> Section number <u>36</u> Township number <u>T 23 S</u> Range number <u>R 12 E</u>																												
2. Distance and direction from nearest town or city: Street address of well location if in city: <u>3 1/2 N 1/4 E Stafford</u> 3. Owner of well: <u>Robert Wendleburg</u> R.R. or street: City, state, zip code: <u>Stafford, Kansas 67578</u>																												
4. Locate with "X" in section below: Sketch map: 																												
5. Type and color of material																												
<table border="1" style="width:100%; border-collapse: collapse;"> <thead> <tr> <th></th> <th>From</th> <th>To</th> </tr> </thead> <tbody> <tr> <td><u>Sand</u></td> <td><u>0</u></td> <td><u>3</u></td> </tr> <tr> <td><u>Clay</u></td> <td><u>3</u></td> <td><u>20</u></td> </tr> <tr> <td><u>fine sand</u></td> <td><u>20</u></td> <td><u>25</u></td> </tr> <tr> <td><u>med. sand</u></td> <td><u>25</u></td> <td><u>41</u></td> </tr> <tr> <td><u>Clay</u></td> <td><u>41</u></td> <td><u>42</u></td> </tr> <tr> <td><u>med. sand</u></td> <td><u>42</u></td> <td><u>66</u></td> </tr> <tr> <td><u>Clay layers</u></td> <td></td> <td></td> </tr> <tr> <td><u>Shale</u></td> <td><u>66</u></td> <td><u>67</u></td> </tr>
6. Bore hole dia. <u>28</u> in. Completion date <u>July 7, 1975</u> Well depth <u>66</u> ft.																												
7. ☐ Cable tool ☐ Rotary ☐ Driven ☐ Dug ☐ Hollow rod ☐ Jetted ☒ Bored ☐ Reverse rotary																												
8. Use: ☐ Domestic ☐ Public supply ☐ Industry ☒ Irrigation ☐ Air conditioning ☐ Stock ☐ Lawn ☐ Oil field water ☐ Other																												
9. Casing: Material <u>Steel</u> Height: Above or below Threaded ☐ Welded ☐ Surface <u>12</u> in. RMP ☐ PVC ☐ Weight <u>30</u> lbs./ft. Dia <u>16</u> in. to <u>40</u> ft. depth Wall Thickness: inches or Dia. <u>16</u> in. to <u>40</u> ft. depth gage No. <u>314</u>																												
10. Screen: Manufacturer's name <u>Johnson</u> Type <u>slotted</u> Dia. <u>16</u> Slot/gauze <u>3/16</u> Length Set between <u>40</u> ft. and <u>66</u> ft. ft. and ft. Gravel pack? <u>yes</u> Size range of material <u>1/8-1/4</u>																												
11. Static water level: <u>24</u> ft. below land surface Date <u>Jan. 23, 75</u> mo./day/yr.																												
12. Pumping level below land surfaces: <u>42</u> ft. after <u>1</u> hrs. pumping <u>1100</u> g.p.m. <u>37</u> ft. after <u>1/2</u> hrs. pumping <u>800</u> g.p.m. Estimated maximum yield <u>1100</u> g.p.m.																												
13. Water sample submitted: <u>Yes</u> ☒ No ☐ Date																												
14. Well head completion: <u>Pitless adapter</u> <u>12</u> inches above grade																												
15. Well grouted <u>yes</u> With: ☒ Neat cement ☐ Bentonite ☐ Concrete Depth: From <u>0</u> ft. to <u>10</u> ft.																												
16. Nearest source of possible contamination <u>Drinking water</u> ft. <u>15</u> Direction <u>WES</u> Type <u>Drinking</u> Well disinfected upon completion? <u>Yes</u> ☒ No ☐																												
17. Pump: <u>Not installed</u> Manufacturer's name <u>Western Land Roller</u> Model number <u>2-10 D</u> HP <u>2.62</u> Volts <u>440</u> Length of drop pipe <u>50</u> ft. capacity <u>1000</u> g.p.m. Type: ☐ Submersible ☒ Turbine ☐ Jet ☐ Reciprocating ☐ Centrifugal ☐ Other																												
(Use a second sheet if needed)																												
18. Elevation: Topography: ☐ Hill ☐ Slope ☒ Upland ☐ Valley	19. Remarks: 20. Water well contractor's certification: This well was drilled under my jurisdiction and this report is true to the best of my knowledge and belief. <u>Darling Drilling Co.</u> <u>189</u> Business name License No. Address <u>1211 W. 4th Hutchinson, Kansas</u> Signed <u>Donald J. Darling</u> Date <u>July 7, 1975</u> Authorized representative																											

Forward the white, blue and pink copies to the Department of Health and Environment

Form WWC-5