

1	LOCATION OF WATER WELL:	Fraction	Section Number	Township Number	Range Number
County:	Stafford	NE $\frac{1}{4}$ NE $\frac{1}{4}$ SW $\frac{1}{4}$	33	T 23 S	R 13 E

1	LOCATION OF WATER WELL:	Fraction	Section Number	Township Number	Range Number
County:	Stafford	NE $\frac{1}{4}$ NE $\frac{1}{4}$ SW $\frac{1}{4}$	33	T 23 S	R 13 E

Distance and direction from nearest town or city street address of well if located within city?


208 S Broadway in St John

WATER WELL OWNER: Ruth Beitler
RR#, St. Address, Box #: 208 S Broadway
City, State, ZIP Code: St. John, KS 67576

Board of Agriculture, Division of Water Resources
Application Number:

3 LOCATE WELL'S LOCATION WITH AN "X" IN SECTION BOX: 4 DEPTH OF COMPLETED WELL: 43 ft. ELEVATION: _____

Depth(s) Groundwater Encountered 1. _____ ft. 2. _____ ft. 3. _____ ft.

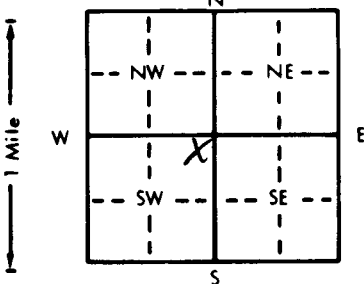

WELL'S STATIC WATER LEVEL ... 18 ... ft. below land surface measured on mo/day/yr 8-10-99
 Pump test data: Well water was 24 ... ft. after 1/2 ... hours pumping 25 ... gpm
 Est. Yield ... gpm: Well water was ... ft. after ... hours pumping ... gpm
 Bore Hole Diameter. 8 ... in. to 4.3 ... ft., and ... in. to ... ft.
 WELL WATER TO BE USED AS: 5 Public water supply 8 Air conditioning 11 Injection well
 1 Domestic 3 Feedlot 6 Oil field water supply 9 Dewatering 12 Other (Specify below)
 2 Irrigation 4 Industrial ⑦ Lawn and garden only 10 Monitoring well
 Was a chemical/bacteriological sample submitted to Department? Yes No X; If yes, mo/day/yr sample was submitted
 Water Well Disinfected? Yes X No

5 TYPE OF BLANK CASING USED: 5 Wrought iron 8 Concrete tile CASING JOINTS: Glued ☒ Clamped ☐
1 Steel 3 RMP (SR) 6 Asbestos-Cement 9 Other (specify below) Welded ☐
☒ PVC 4 ABS 7 Fiberglass Threaded ☐
Blank casing diameter 5 in. to 33 ft. Dia. in. to . ft. Dia. in. to . ft.
Casing height above land surface 12 in. weight 2.29 lbs./ft. Wall thickness or gauge No. 160

TYPE OF SCREEN OR PERFORATION MATERIAL:

1 Steel	3 Stainless steel	5 Fiberglass	7 PVC	10 Asbestos-cement
2 Brass	4 Galvanized steel	6 Concrete tile	8 RMP (SR)	11 Other (specify)
			9 ABS	12 None used (open hole)

SCREEN OR PERFORATION OPENINGS ARE:

1 Continuous slot	3 Mill slot	5 Gauzed wrapped	8 Saw cut	11 None (open hole)
2 Louvered shutter	4 Key punched	6 Wire wrapped	9 Drilled holes	
		7 Torch cut	10 Other (specify)	

SCREEN-PERFORATED INTERVALS:	From	33	ft. to	43	ft. From		ft. to		ft.
	From		ft. to		ft. From		ft. to		ft.
GRAVEL PACK INTERVALS:	From	22	ft. to	43	ft. From		ft. to		ft.
	From		ft. to		ft. From		ft. to		ft.

6 GROUT MATERIAL: 1 Neat cement 2 Cement grout 3 Bentonite 4 Other

Grout Intervals: From 2 ft. to 22 ft. From ft. to ft. From ft. to ft.

What is the nearest source of possible contamination:

1 Septic tank	4 Lateral lines	7 Pit privy	10 Livestock pens	14 Abandoned water well
2 Sewer lines	5 Cess pool	8 Sewage lagoon	11 Fuel storage	15 Oil well/Gas well
3 Watertight sewer lines	6 Seepage pit	9 Feedyard	12 Fertilizer storage	16 Other (specify below)
13 Insecticide storage				

Direction from well? W

How many feet? 50

[illegible]

7. CONTRACTOR'S OR LANDOWNER'S CERTIFICATION: This water well was (1) constructed, (2) reconstructed, or (3) plugged under my jurisdiction and was completed on (mo/day/year) 8-10-99 and this record is true to the best of my knowledge and belief. Kansas Water Well Contractor's License No. 447 This Water Well Record was completed on (mo/day/yr) 8-13-99 under the business name of Miller Drilling by (signature) [Signature]