


1 LOCATION OF WATER WELL: Fraction Section Number Township Number Range Number
 County: **Stafford** NE 1/4 SW 1/4 SW 1/4 33 T 23 S R 13 EW

Distance and direction from nearest town or city street address of well if located within city?
113 W. 4th Street, St. John, Kansas

2 WATER WELL OWNER: Jim's Amoco
 RR#, St. Address, Box # : 113 West 4th Street
 City, State, ZIP Code : St. John, Kansas 67576
 Board of Agriculture, Division of Water Resources
 Application Number:

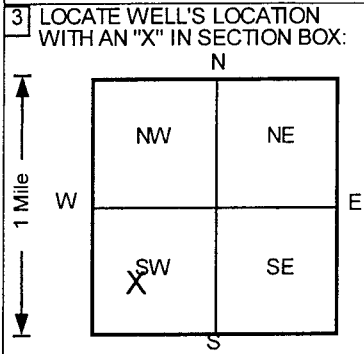

4 DEPTH OF COMPLETED WELL **40** ft ELEVATION: **1906.46**

Depth(s) Groundwater Encountered 1. ft 2. ft 3. ft

WELL'S STATIC WATER LEVEL ft below land surface measured on mo/day/yr

Pump test data: Well water was **NA** ft after hours pumping gpm

Est. Yield **NA** gpm: Well water was ft after hours pumping gpm

Bore Hole Diameter **8** in. to **40** ft, and in. to ft

WELL WATER TO BE USED AS: 5 Public water supply 8 Air conditioning 11 Injection well
 1 Domestic 3 Feedlot 6 Oil field water supply 9 Dewatering **12 Other (Specify below)**
 2 Irrigation 4 Industrial 7 Lawn and garden only 10 Monitoring well **Air Sparge Well**

Was a chemical/bacteriological sample submitted to Department? Yes.....No.....; If yes, mo/day/yr sample was submitted Water Well Disinfected? Yes No

5 TYPE OF BLANK CASING USED: 5 Wrought iron 8 Concrete tile CASING JOINTS: Glued Clamped

1 Steel 3 RMP (SR) 6 Asbestos-Cement 9 Other (specify below) Welded

2 PVC 4 ABS 7 Fiberglass Threaded.

Blank casing diameter **1** in. to **38** ft, Dia in. to ft, Dia in. to ft

Casing height above land surface **-1.68** in., weight **Sch 40** lbs./ft. Wall thickness or gauge No.

TYPE OF SCREEN OR PERFORATION MATERIAL **7** PVC 10 Asbestos-cement

1 Steel 3 Stainless steel 5 Fiberglass **8** RMP (SR) 11 Other (specify)

2 Brass 4 Galvanized steel 6 Concrete tile 9 ABS 12 None used (open hole)

SCREEN OR PERFORATION OPENINGS ARE: 5 Gauzed wrapped 8 Saw cut 11 None (open hole)

1 Continuous slot **3** Mill slot 6 Wire wrapped 9 Drilled holes

2 Louvered shutter 4 Key punched 7 Torch cut 10 Other (specify)

SCREEN-PERFORATED INTERVALS: From **38** ft to **40** ft, From ft to ft

GRAVEL PACK INTERVALS: From **37.5** ft to **40** ft, From ft to ft

6 GROUT MATERIAL: 1 Neat cement **2** Cement grout **3** Bentonite 4 Other

Grout Intervals: From **0** ft to **32.5** ft, From **32.5** ft to **37.5** ft, From ft to ft

What is the nearest source of possible contamination:
 1 Septic tank 4 Lateral lines 7 Pit privy 10 Livestock pens 14 Abandoned water well
 2 Sewer lines 5 Cess pool 8 Sewage lagoon 11 Fuel storage 15 Oil well/Gas well
 3 Watertight sewer lines 6 Seepage pit 9 Feedyard 12 Fertilizer storage **16** Other (specify below)
 **Former UST Basin**

Direction from well? **West** How many feet? **150**

FROM	TO	LITHOLOGIC LOG	FROM	TO	PLUGGING INTERVALS
0	8	Clay, Dark Brown			
8	10	Sand, Dark Gray			
10	20	Sand, Gray Brown			
20	26	Sand, Gray			
26	40	Sand, Gray			
					AS-7, Tag # 00295709, Flushmount
					Project Name: Greenfield - Jim's Amoco
					GeoCore # 830, KDHE # UI 093 11433

7 CONTRACTOR'S OR LANDOWNER'S CERTIFICATION: This water well was **(1)** constructed, (2) reconstructed, or (3) plugged under my jurisdiction and was completed on (mo/day/year) **12/21/99** and this record is true to the best of my knowledge and belief.
 Kansas Water Well Contractor's License No. **527** This Water Well Record was completed on (mo/day/yr) **1/19/00**
 under the business name of **GeoCore Services, Inc.** by (signature) *[Signature]*