


AS-11

1	LOCATION OF WATER WELL:	Fraction	Section Number	Township Number	Range Number
	County: <u>Stafford</u>	<u>NE 1/4 SW 1/4 SW 1/4</u>	<u>33</u>	<u>23</u>	<u>13</u> <small>EW</small>

Distance and direction from nearest town or city street address of well if located within city?
112 W. 4th St. St. John KS 67576

2 WATER WELL OWNER: St. John Service
 RR #, St. Address, Box #: 112 W. 4th St.
 City, State, ZIP Code: St. John KS 67576
 Board of Agriculture, Division of Water Resources
 Application Number:

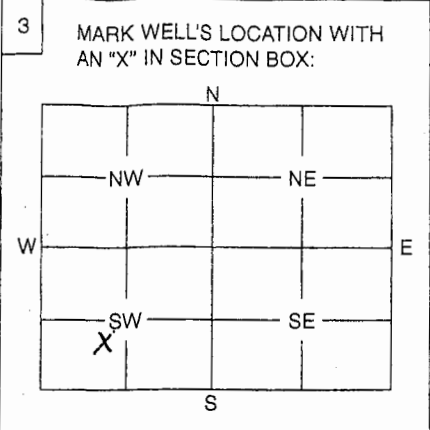

4 DEPTH OF WELL 40 ft.
 WELL'S STATIC WATER LEVEL 21.8 ft.
 WELL WAS USED AS:
 1 Domestic 5 Public Water Supply 9 Dewatering
 2 Irrigation 6 Oil Field Water Supply 10 Monitoring Well
 3 Feedlot 7 Domestic (Lawn & Garden) 11 Injection Well
 4 Industrial 8 Air Conditioning 12 Other

Was a chemical / bacteriological sample submitted to Department? Yes No X.....
 If yes, mo/day/yr sample was submitted

Water Well Disinfected: Yes No X.....

5 TYPE OF BLANK CASING USED:
 1 Steel 3 RMP (SR) 5 Wrought 7 Fiberglass 9 Other (Specify below)
2 PVC 4 ABS 6 Asbestos-Cement 8 Concrete Tile

Blank casing diameter 1 in. Was casing pulled? Yes X No If yes, how much 3'
 Casing height above or below land surface in.

6 GROUT PLUG MATERIAL: 1 Neat cement 2 Cement grout 3 Bentonite 4 Other

Grout Plug Intervals: From 40 ft. to 3 ft., From ft. to ft., From to

What is the nearest source of possible contamination:
 1 Septic tank 6 Seepage pit 11 Fuel storage 16 Other (specify below)
 2 Sewer lines 7 Pit privy 12 Fertilizer storage
 3 Watertight sewer lines 8 Sewage lagoon 13 Insecticide storage
 4 Lateral lines 9 Feedyard 14 Abandoned water well
 5 Cess pool 10 Livestock pens 15 Oil well/Gas well

Direction from well? N How many feet? 225

FROM	TO	PLUGGING MATERIALS
<u>40'</u>	<u>3'</u>	<u>Bentonite chips</u>
<u>3'</u>	<u>0'</u>	<u>Native material</u>

7 CONTRACTOR'S OF LANDOWNER'S CERTIFICATION: This water well was plugged under my jurisdiction and was completed on (mo/day/year) 4-4-07 and this record is true to the best of my knowledge and belief. Kansas Water Well Contractor's License No. 6-25-07 This Water Well Record was completed on (mo/day/year) 6-25-07 under the business name of GreenField Contractors by (signature) John P. ...