

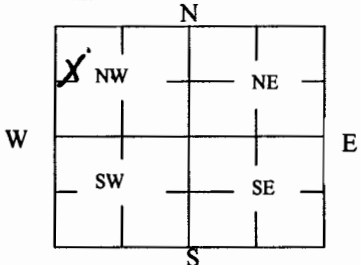
WATER WELL PLUGGING RECORD Form WWC-5P KSA 82a-1212 ID NO.

1 LOCATION OF WATER WELL: County: STAFFORD	Fraction SW ¼ NW ¼ NW ¼ ¼	Section Number 9	Township Number T 23 S	Range Number 13 ☐ E ☒ W
---	------------------------------	----------------------------	----------------------------------	---

Street/Rural Address of Well Location; if unknown, distance & direction from nearest town or intersection: If at owner's address, check here ☐ CONSTRUED 3 @ 310'

Global Positioning Systems (GPS) information:
 Latitude: 38.06864 (in decimal degrees)
 Longitude: -98.76491 (in decimal degrees)
 Elevation: _____
 Datum: ☐ WGS84, ☐ NAD83, ☐ NAD27
 Collection Method:
☒ GPS unit (Make/Model: MAGELLEN)
☐ Digital Map/Photo, ☐ Topographic Map, ☐ Land Survey
 Est. Accuracy: ☐ < 3 m, ☐ 3-5 m, ☐ 5-15 m, ☐ > 15 m

2 WATER WELL OWNER: **BRIAN DUNN**
 RR#, St. Address, Box #: **RR**
 City, State ZIP Code: **ST. JOHN, KS 67578**

3 MARK WELL'S LOCATION WITH AN "X" IN SECTION BOX:


4 DEPTH OF WELL 310 ft.
 WELL'S STATIC WATER LEVEL NA ft
 WELL WAS USED AS:

☐ Domestic	☐ Public Water Supply	☐ Dewatering
☐ Irrigation	☐ Oil Field Water Supply	☐ Monitoring
☐ Feedlot	☐ Domestic (Lawn & Garden)	☐ Injection Well
☐ Industrial	☐ Air Conditioning	☒ Other <u>Geothermal</u>

 Was a chemical/bacteriological sample submitted to Department? Yes ☐ No ☐

5 TYPE OF BLANK CASING USED:

☐ Steel	☐ RMP (SR)	☐ Wrought	☐ Fiberglass	☒ Other (Specify below)
☐ PVC	☐ ABS	☐ Asbestos-Cement	☐ Concrete Tile	<u>NA</u>

Blank casing diameter _____ in. Was casing pulled? Yes ☐ No ☐ If yes, how much _____

Casing height above or below land surface _____ in.

6 GROUT PLUG MATERIAL: ☐ Neat cement ☐ Cement grout ☒ Bentonite ☐ Other _____
 Grout Plug Intervals: From 0 ft. to 280 ft., From _____ ft. to _____ ft., From _____ to _____ ft.
 What is the nearest source of possible contamination:

☐ Septic tank	☐ Seepage pit	☐ Fuel Storage	☒ Other (specify below)
☐ Sewer lines	☐ Pit privy	☐ Fertilizer storage	<u>HOUSE</u>
☐ Watertight sewer lines	☐ Sewage lagoon	☐ Insecticide storage	
☐ Lateral lines	☐ Feedyard	☐ Abandoned water well	Direction from well? <u>SOUTHEAST</u>
☐ Cess pool	☐ Livestock pens	☐ Oil well/Gas well	How many feet? <u>30</u>

FROM	TO	PLUGGING MATERIALS	FROM	TO	PLUGGING MATERIALS
0	36	RED SANDY CLAY			
36	135	SAND & GRAVEL			
135	180	RED CLAY			
180	205	GRAY CLAY			
205	306	WHITE SAND			
306	310	RED CLAY			

7 CONTRACTOR'S OR LANDOWNER'S CERTIFICATION: This water well was plugged under my jurisdiction and was completed on (mo/day/year) 11/7/12 and this record is true to the best of my knowledge and belief. Kansas Water Well Contractor's License No. 812. This Water Well Record was completed on (mo/day/year) 12/10/12 under the business name of Environmental Loop Service, Inc by (signature) Richard Moore

INSTRUCTIONS: Use typewriter or ballpoint pen. Please press firmly and print clearly. Please fill in blanks, underline or circle the correct answers. Send top three copies to Kansas Department of Health and Environment, Bureau of Water, Geology Section, 1000 SW Jackson St., Ste. 420, Topeka, Kansas 66612-1367. Telephone: 785/296-5524. Send one to Water Well Owner and retain one for your records. Visit us at <http://www.kdheks.gov/waterwell/index.html>.

Check one: ☒ White Copy ☐ Blue Copy ☐ Pink Copy