

WATER WELL PLUGGING RECORD Form WWC-5P KSA 82a-1212 ID NO.

MW18


1 LOCATION OF WATER WELL: County: Stafford	Fraction NE ¼ SW ¼ SW ¼	Section Number 33	Township Number T 23 S	Range Number 13 <input type="checkbox"/> E <input checked="" type="checkbox"/> W
--	----------------------------	----------------------	---------------------------	---

Street/Rural Address of Well Location; if unknown, distance & direction from nearest town or intersection: If at owner's address, check here
113 W. 4th St., St. John, KS

Global Positioning Systems (GPS) information:
Latitude: NA (in decimal degrees)
Longitude: NA (in decimal degrees)
Elevation: NA
Horizontal Datum WGS84, NAD83, NAD27
Collection Method:

2 WATER WELL OWNER: Jim's Amoco
RR#, St. Address, Box #: 113 W 4th St
City, State ZIP Code: St. John, KS 67576

GPS unit (Make/model: _____)
 Digital Map/Photo, Topographic Map Land Survey
Est. Accuracy: <3 m, 3-5 m, 5-15 m, >15 m

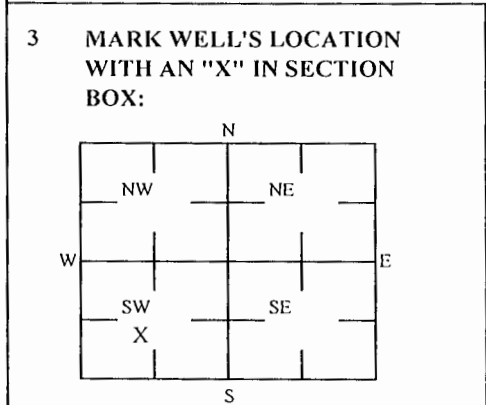

4 DEPTH OF WELL 19.1 ft.
WELL'S STATIC WATER LEVEL NA ft
WELL WAS USED AS:
 Domestic Public Water Supply Dewatering
 Irrigation Oil Field Water Supply Monitoring
 Feedlot Domestic (Lawn & Garden) Injection Well
 Industrial Air Conditioning Other _____
Was a chemical/bacteriological sample submitted to Department? Yes No

5 TYPE OF BLANK CASING USED:
 Steel RMP (SR) Wrought Fiberglass Other (Specific below)
 PVC ABS Asbestos-Cement Concrete Tile
Blank casing diameter 2 in. Was casing pulled? Yes No If yes, how much 3'
Casing height above or below land surface NA in.

6 GROUT PLUG MATERIAL: Neat cement Cement grout Bentonite Other Soil: 0-3'
Grout Plug Intervals: From 3 ft to 19.1 ft, From _____ ft to _____ ft, From _____ ft to _____ ft.
What is the nearest source of possible contamination:
 Septic tank Seepage pit Fuel storage Other (specify below) _____
 Sewer lines Pit privy Fertilizer storage _____
 Watertight sewer lines Sewage lagoon Insecticide storage _____
 Lateral lines Feed yard Abandoned water well Direction from well? _____
 Cess pool Livestock pens Oil well/Gas well How many feet? _____

FROM	TO	PLUGGING MATERIALS	FROM	TO	PLUGGING MATERIALS
0	3	Soil			
3	19.1	Bentonite			

7 CONTRACTOR'S OR LANDOWNER'S CERTIFICATION: This water well was plugged under my jurisdiction and was completed on (mo/day/year) 4/12/2022 and this record is true to the best of my knowledge and belief. Kansas Water Contractor's License No. 757. This Water Well Record was completed on (mo/day/year) 4/25/2022 under the business name of Larsen & Associates, Inc. By (signature) _____

Send one white copy to Kansas Department of Health & Environment, Geology Section, 1000 SW Jackson Street, Ste. 420, Topeka, KS 66612-1367. Send one copy to WATER WELL OWNER and retain one for your records
Visit us at <http://www.kdheks.gov/waterwell/index.html> Telephone 785-296-5524.

Stafford

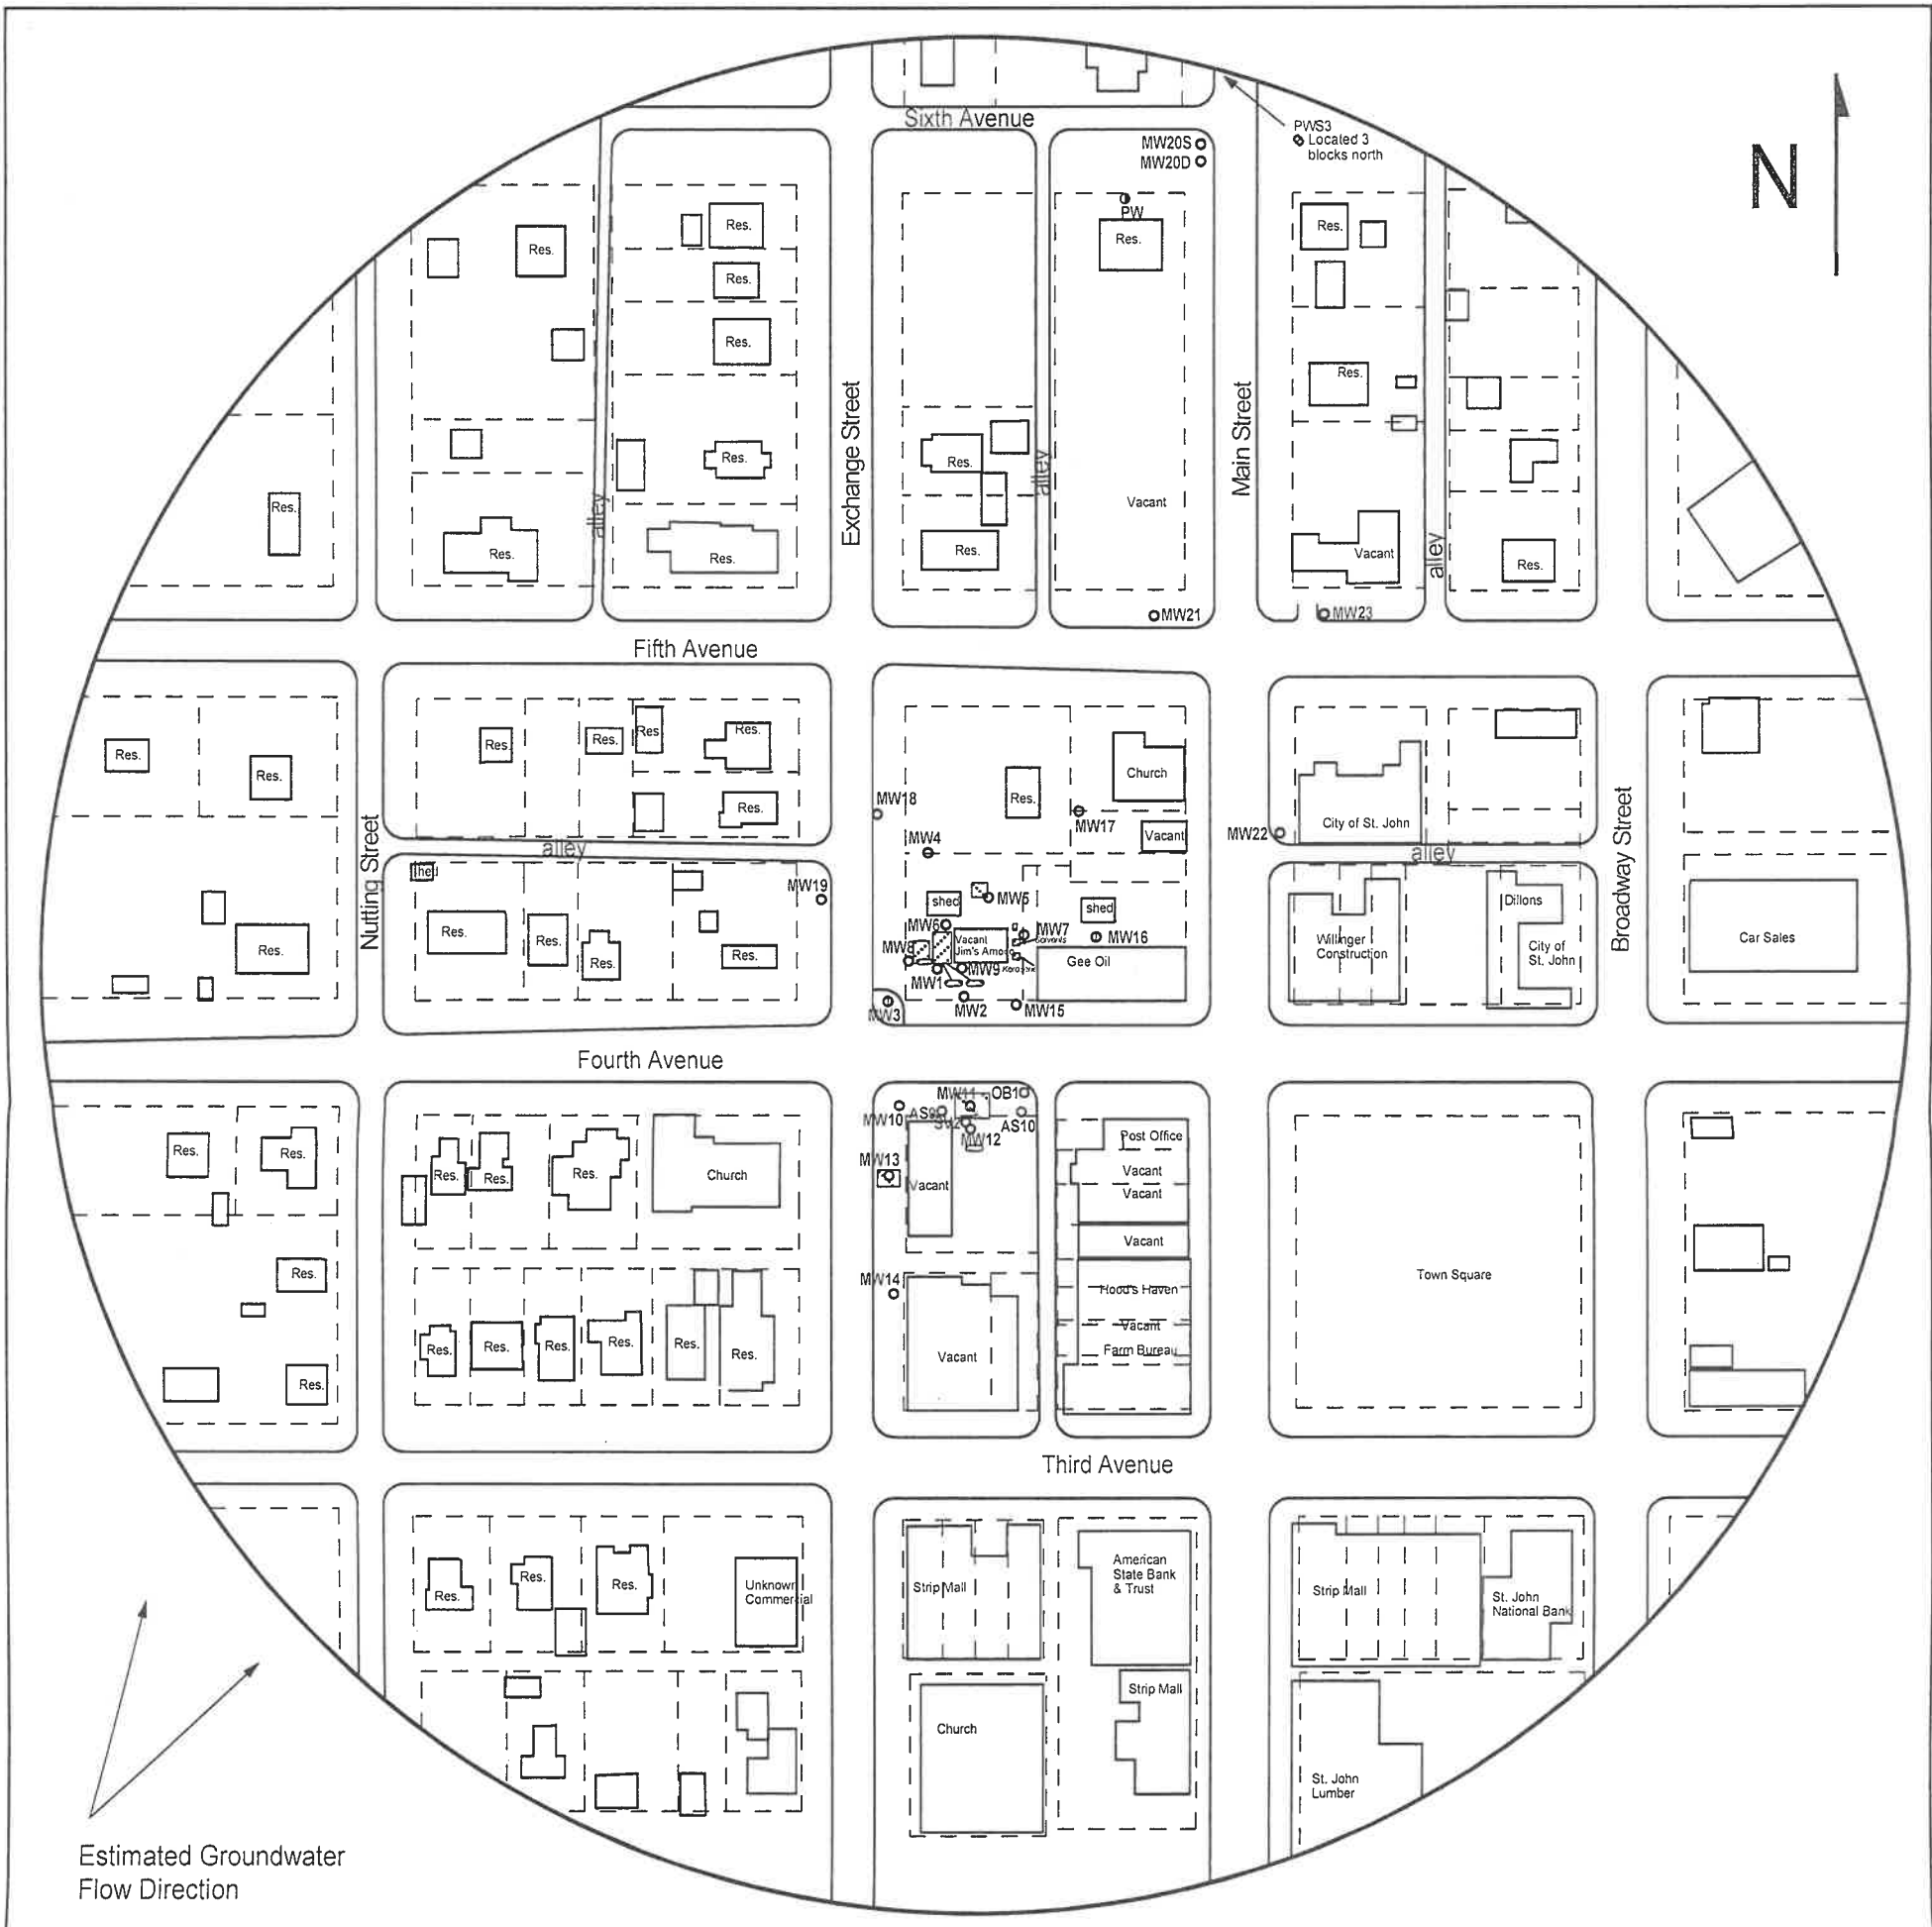


FIGURE 1 - 600 FT RADIUS AREA BASE MAP

LEGEND

- Approximate Location of Active UST Basin, Pump Islands, and Product Lines
- Approximate Location of Former UST Basin and Pump Island
- Approximate Location of Former Waste Oil UST Basin
- Approximate Location of Former Used Motor Oil AST Basin
- Approximate Location of Property Lines
- Monitoring Well
- Plugged Monitoring Well
- Destroyed Monitoring Well
- Private Well
- Public Water Well

PROJECT:

Jim's Amoco
 113 W. 4th
 St. John, KS
 KDHE ID: U1-093-11433
 Date: 4/12/22



1311 E 25th St., Suite B (785) 841-8707 office
 Lawrence, KS 66046 (785) 865-4282 fax



RECEIVED

APR 28 2022

BUREAU OF WATER

23-23-13W