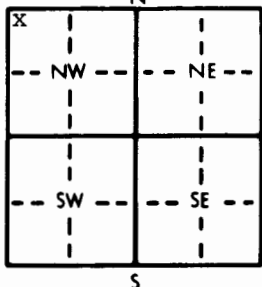


1 LOCATION OF WATER WELL: County: <u>Stafford</u>	Fraction <u>NW 1/4 NW 1/4 NW 1/4</u>	Section Number <u>6</u>	Township Number <u>T 23 S</u>	Range Number <u>R 13 E/W</u>
--	---	----------------------------	----------------------------------	---------------------------------

Distance and direction from nearest town or city street address of well if located within city?
 Approx. 6 miles south of Seward, KS

2 WATER WELL OWNER: Big Bend GMD #5
 RR#, St. Address, Box #: P.O. Box 7
 City, State, ZIP Code: Stafford, KS 67578
 Board of Agriculture, Division of Water Resources
 Application Number: not required

3 LOCATE WELL'S LOCATION WITH AN "X" IN SECTION BOX:


4 DEPTH OF COMPLETED WELL: 104 ft. ELEVATION: unknown
 Depth(s) Groundwater Encountered 1. 26.5 ft. 2. _____ ft. 3. _____ ft.
 WELL'S STATIC WATER LEVEL 26.5 ft. below land surface measured on mo/day/yr 11/19/86
 Pump test data: Well water was not ck'd ft. after _____ hours pumping _____ gpm
 Est. Yield unknown gpm: Well water was _____ ft. after _____ hours pumping _____ gpm
 Bore Hole Diameter .9 in. to 1.02 ft., and _____ in. to _____ ft.
 WELL WATER TO BE USED AS:
 5 Public water supply 8 Air conditioning 11 Injection well
 1 Domestic 3 Feedlot 6 Oil field water supply 9 Dewatering 12 Other (Specify below)
 2 Irrigation 4 Industrial 7 Lawn and garden only 10 Observation well
 Was a chemical/bacteriological sample submitted to Department? Yes _____ No X _____; If yes, mo/day/yr sample was submitted _____
 Water Well Disinfected? Yes _____ No X _____

5 TYPE OF BLANK CASING USED:
 1 Steel 3 RMP (SR) 5 Wrought iron 8 Concrete tile CASING JOINTS: Glued X Clamped _____
 2 PVC 4 ABS 6 Asbestos-Cement 9 Other (specify below) Welded _____
 7 Fiberglass Threaded _____
 Blank casing diameter 5 in. to 9.7 ft., Dia _____ in. to _____ ft., Dia _____ in. to _____ ft.
 Casing height above land surface 24 in., weight 2.788 lbs./ft. Wall thickness or gauge No. .265
 TYPE OF SCREEN OR PERFORATION MATERIAL:
 1 Steel 3 Stainless steel 5 Fiberglass 7 PVC 10 Asbestos-cement
 2 Brass 4 Galvanized steel 6 Concrete tile 8 RMP (SR) 11 Other (specify) _____
 12 None used (open hole)
 SCREEN OR PERFORATION OPENINGS ARE:
 1 Continuous slot 3 Mill slot 5 Gauzed wrapped 8 Saw cut 11 None (open hole)
 2 Louvered shutter 4 Key punched 6 Wire wrapped 9 Drilled holes
 7 Torch cut 10 Other (specify) _____
 SCREEN-PERFORATED INTERVALS: From 9.7 ft. to 102 ft., From _____ ft. to _____ ft.
 From _____ ft. to _____ ft., From _____ ft. to _____ ft.
 GRAVEL PACK INTERVALS: From 8.7 ft. to 102 ft., From _____ ft. to _____ ft.
 From _____ ft. to _____ ft., From _____ ft. to _____ ft.

6 GROUT MATERIAL: 1 Neat cement 2 Cement grout 3 Bentonite 4 Other _____
 Grout Intervals: From 0 ft. to 8.7 ft., From _____ ft. to _____ ft., From _____ ft. to _____ ft.
 What is the nearest source of possible contamination:
 1 Septic tank 4 Lateral lines 7 Pit privy 10 Livestock pens 14 Abandoned water well
 2 Sewer lines 5 Cess pool 8 Sewage lagoon 11 Fuel storage 15 Oil well/Gas well
 3 Watertight sewer lines 6 Seepage pit 9 Feedyard 12 Fertilizer storage 16 Other (specify below)
FIELD
 Direction from well? all How many feet? _____

FROM	TO	LITHOLOGIC LOG	FROM	TO	LITHOLOGIC LOG
0	45	Sandy topsoil & sandy brown clay			
45	102	Sand & gravel, med. to fine w/ streaks of tan clay @ 54'			


7 CONTRACTOR'S OR LANDOWNER'S CERTIFICATION: This water well was (1) constructed, (2) reconstructed, or (3) plugged under my jurisdiction and was completed on (mo/day/year) XX 11/19/86 and this record is true to the best of my knowledge and belief. Kansas Water Well Contractor's License No. 185 This Water Well Record was completed on (mo/day/yr) 11/20/86
 under the business name of Clarke Well & Equipment, Inc. by (signature) [Signature]

INSTRUCTIONS: Use typewriter or ball point pen. PLEASE PRESS FIRMLY and PRINT clearly. Please fill in blanks, underline or circle the correct answers. Send top three copies to Kansas Department of Health and Environment, Office of Oil Field and Environmental Geology, Regulation and Permitting Section, Topeka, Kansas 66620-7500, Telephone: 913-862-9360. Send one to WATER WELL OWNER and retain one for your records.

OFFICE USE ONLY
T
R
EW
SEC.

SITE NUMBER : 52
SITE LOCATION : NW NW NW
LEGAL LOCATION : 6-23-13
COUNTY : Stafford

LANDOWNER : Gleason Ranch, Inc
ADDRESS : RR 2 Box 6E
Larned, KS 67550
PHONE NO. :

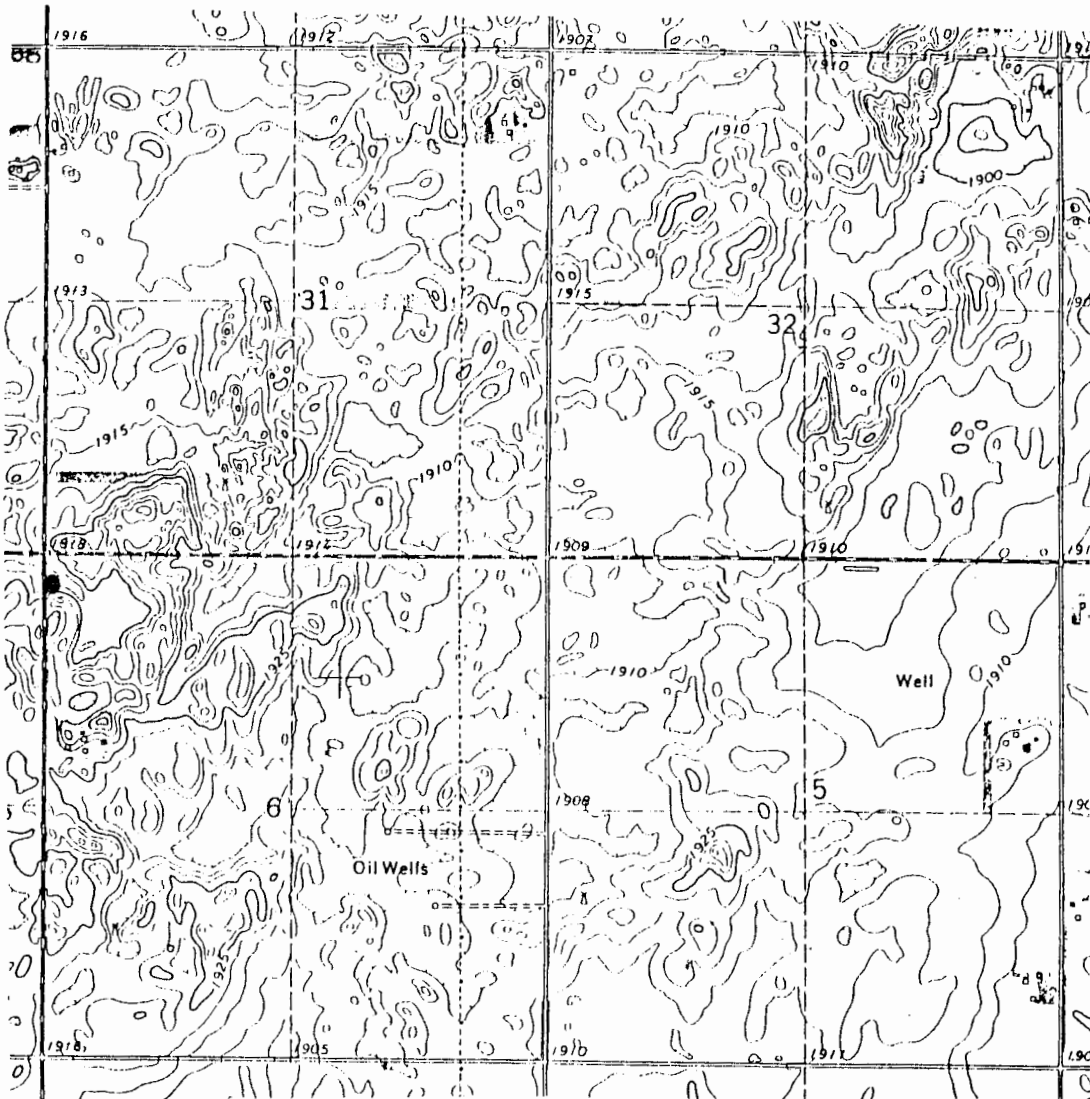

2
1
20

WELL LOCATION *

WELL NAME: SITE52

UNSATURATED
 WATER CONTENT
 TOTAL LIQUID
 VOLUME RATIO

DEPTH	COMPONENTS	COMMENTS	PROP U/R	SUR REQ	SHRUG
0			.96	.00	.00
10			.96	.00	.00
20			.95	.00	.00
30			.72	.00	.00
40			.65	.00	.00
50			.79	.00	.00
60			.65	.00	.00
70			.64	.00	.00
80			.68	.00	.00
90			.63	.00	.00
100			.77	.00	.00
110			.63	.00	.00
120			.70	.00	.00
130			.87	.00	.00
140			.87	.00	.00
150			.68	.00	.00
160			.69	.00	.00