


1	LOCATION OF WATER WELL: County: Stafford	Fraction $\frac{1}{4}$	Near Center $\frac{1}{4}$ SE $\frac{1}{4}$	Section Number 7	Township Number T 23 S	Range Number R 13 E (W)
---	--	---------------------------	---	----------------------------	----------------------------------	--

Distance and direction from nearest town or city street address of well if located within city?

Approximately 4 miles north and 2 miles west of St. John, KS

2	WATER WELL OWNER:	Glenn Smith	
	RR#, St. Address, Box # :	121 South Main	Board of Agriculture, Division of Water Resources
	City, State, ZIP Code :	St. John, KS 67576	Application Number: 37 961

3 LOCATE WELL'S LOCATION WITH AN "X" IN SECTION BOX: 4 DEPTH OF COMPLETED WELL: 92 ft. ELEVATION: unknown

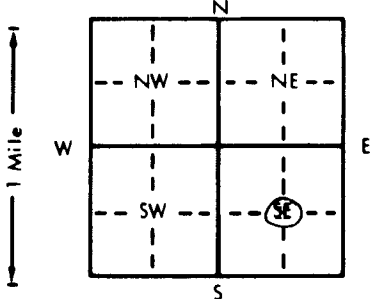

Depth(s) Groundwater Encountered 1. ft. 2. ft. 3. ft.

WELL'S STATIC WATER LEVEL . . . 17 ft. below land surface measured on mo/day/yr

Pump test data: Well water was not ch'd ft. after hours pumping gpm

Est. Yield unknown gpm: Well water was ft. after hours pumping gpm

Bore Hole Diameter . . . 24 in. to . . . 92 ft., and in. to ft.

WELL WATER TO BE USED AS:

1 Domestic	3 Feedlot	6 Oil field water supply	9 Dewatering	11 Injection well
2 Irrigation	4 Industrial	7 Lawn and garden only	10 Monitoring well	12 Other (Specify below)

Was a chemical/bacteriological sample submitted to Department? Yes. No. ☒; If yes, mo/day/yr sample was submitted

Water Well Disinfected? Yes No ☒

5	TYPE OF BLANK CASING USED:		5 Wrought iron	8 Concrete tile	CASING JOINTS: Glued Clamped
	1 <u>Steel</u>	3 RMP (SR)	6 Asbestos-Cement	9 Other (specify below)	Welded . . . X
	2 PVC	4 ABS	7 Fiberglass		Threaded

Blank casing diameter . . . 16 . . . in. to . . . 51 . . . ft. Dia . . . in. to . . . ft. Dia . . . in. to . . . ft.
Casing height above land surface . . . 12 . . . in., weight . . . 42.05 . . . lbs./ft. Wall thickness or gauge No. . . 250.

TYPE OF SCREEN OR PERFORATION MATERIAL:			7 PVC	10 Asbestos-cement
1 <u>Steel</u>	3 Stainless steel	5 Fiberglass	8 RMP (SR)	11 Other (specify)
2 Brass	4 Galvanized steel	6 Concrete tile	9 ABS	12 None used (open hole)

SCREEN OR PERFORATION OPENINGS ARE:		5 Gauzed wrapped	8 Saw cut	11 None (open hole)
1 Continuous slot	3 Mill slot	6 Wire wrapped	9 Drilled holes	
2 Louvered shutter	4 Key punched	7 Torch cut	10 Other (specify)	

SCREEN-PERFORATED INTERVALS:	From	51	ft. to	91	ft., From	ft. to	ft.
	From		ft. to		ft., From	ft. to	ft.
GRAVEL PACK INTERVALS:	From	18	ft. to	92	ft., From	ft. to	ft.
	From		ft. to		ft., From	ft. to	ft.

6 GROUT MATERIAL: 1 Neat cement 2 Cement grout 3 Bentonite 4 Other

Grout Intervals: From 0 ft. to 18 ft. From ft. to ft. From ft. to ft.

What is the nearest source of possible contamination:

1 Septic tank	4 Lateral lines	7 Pit privy	10 Livestock pens	14 Abandoned water well
2 Sewer lines	5 Cess pool	8 Sewage lagoon	11 Fuel storage	15 Oil well/Gas well
3 Watertight sewer lines	6 Seepage pit	9 Feedyard	12 Fertilizer storage	16 Other (specify below)
			13 Insecticide storage	... none, known ...

Direction from well? _____ How many feet? _____

[illegible]

7 CONTRACTOR'S OR LANDOWNER'S CERTIFICATION: This water well was (1) constructed, (2) reconstructed, or (3) plugged under my jurisdiction and was completed on (mo/day/year) 7-31-89 and this record is true to the best of my knowledge and belief. Kansas Water Well Contractor's License No. 185 This Water Well Record was completed on (mo/day/yr) 8-3-89 under the business name of Clarke Well & Equipment, Inc. by (signature) 