USE TYPEWRITER OR BALL POINT PEN-PRESS FIRMLY, PRINT CLEARLY.

T R EW sec 1/4 1/4 1/4 No.

WATER WELL RECORD
KSA 82a-1201-1215

Kansas State Dept. Of Health
(Water Well Contractors)
Forbes-Bldg. 740
Topeka, Kansas 66620

1 Location of well:	County	Township name	Froction	Section number	Town number	Range number
	Stafford		NW NW NE	20	23S	13W

Distance and direction from nearest town or city: 3 north
Street address of well location if in city: 1½ west of St John

3 Owner of well: Phillip Schultz
Address: St John Kansas

Locate with "X" in section below: Sketch map:

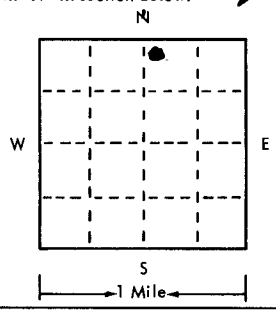

4 Well depth: 50 ft. Date of completion 7-26-75
Well diameter 8 in.

5 ☐ Cable tool ☒ Rotary ☐ Driven ☐ Dug
☐ Hollow rod ☐ Jetted ☐ Bored ☐ Reverse rotary

6 Use: ☐ Domestic ☐ Public supply ☐ Industry
☒ Irrigation ☐ Air conditioning ☐ Commercial
☐ Test well ☒ Oil Port Grass

7 Casing: Material RMP Height: (above)/below
Threaded ☐ Welded ☒ Surface 12 in.
Diam. 5 in. to 50 ft. depth Weight 14# lbs./ft 120
Drive shoe? ☐ Yes ☒ No
— in. to — ft. depth

2 Type and color of material	From	To
Clay	0	12
Sand	12	30
Clay	30	35
Gravel	35	50
(use a second sheet if needed)		

8 Screen:
Manufacturer Jensen Lowell
Type RMP Dia. 5
Slot/gauze 8 Length 10
Set between 40 ft. and 50 ft.
Fittings:
Gravel pack ☒ Yes ☐ No Size range of material 1/4 84

9 Static water level:
20 ft. below land surface Date 7-20-75

10 Pumping level below land surfaces:
— ft. after — hrs. pumping — g.p.m.
— ft. after — hrs. pumping — g.p.m.
Estimated maximum yield — g.p.m.

11 Water sample submitted:
☐ Yes ☒ No Date —

12 Well head completion:
☐ Pitless adapter ☐ Inches above grade

13 Well grouted? ☒ Yes ☐ No
☐ Neat cement ☒ Bentonite ☐ —
Depth: From 0 ft. to 10 ft.

14 Nearest source of possible contamination:
ft. — Direction — Type —
Well disinfected upon completion? ☐ Yes ☐ No

15 Pump: ☒ Not installed
Manufacturer's name —
Model number — HP — Volts —
Length of drop pipe — ft. capacity — g.m.p.
Type:
☐ Submersible ☐ Turbine
☐ Jet ☐ Reciprocating
☐ Certrifugal ☐ Other

16 Remarks: elevation

Topagraphy:
☐ Hill
☒ Slope
☐ Upland
☐ Valley

17 Water well contractor's certification:
This well was drilled under my jurisdiction and this report is true to the best of my knowledge and belief.
Myers Water Well 143
Business name License No.
Address Great Bend KS
Signed Orfred D Myers Date 7-20-75
Authorized representative

Forward the white, blue and pink copies to the Kansas State Dept. Of Health.

Form WWC-5

677-H