USE TYPEWRITER OR BALL POINT PEN-PRESS FIRMLY, PRINT CLEARLY.

WATER WELL RECORD
KSA 82a-1201-1215

Kansas Department of Health and Environment-Division of Environment
(Water well Contractors)
Topeka, Kansas 66620

| 1. Location of well: | County | Fraction | Section number | Township number | Range number |
|---|---|---|---|---|---|
| | Stafford | 1/4 CSW 1/4 NW 1/4 | 21 | T 23 S | R 13 E/W |

2. Distance and direction from nearest town or city: 1½ N

Street address of well location if in city: St. John, KS

3. Owner of well: Maurice Francis

R.R. or street: R3

City, state, zip code: St. John, KS

4. Locate with "X" in section below:

Sketch map:

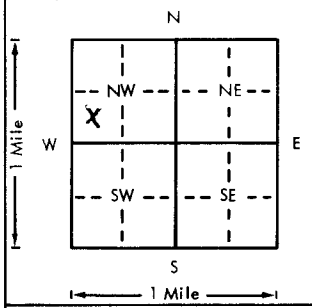


6. Bore hole dia. 9 in. Completion date
Well depth 52 ft. 5-18-77

7. __ Cable tool X Rotary __ Driven __ Dug
__ Hollow rod __ Jetted __ Bored __ Reverse rotary

8. Use: __ Domestic __ Public supply __ Industry
__ Irrigation __ Air conditioning X Stock
__ Lawn __ Oil field water __ Other

9. Casing: Material
Threaded __ Welded __
RMP __ PVC X
Dia. 6 in. to 52 ft. depth
Dia. __ in. to __ ft. depth
Height: Above ~~or below~~
Surface 12 in.
Weight lbs./ft.
Wall Thickness: inches or gage No. SCH 40

| 5. Type and color of material | From | To |
|---|---|---|
| Top Soil - Clay | 0 | 30 |
| Sand - Gravel | 30 | 52 |

10. Screen: Manufacturer's name Peerless
Type PVC Dia. 6
Slot/gauze 1/16" Length 20
Set between 32 ft. and 52 ft.
ft. and ft.
Gravel pack? X Size range of material 1/8-3/4

11. Static water level: mo./day/yr.
11 ft. below land surface Date 5-18-77

12. Pumping level below land surfaces:
ft. after hrs. pumping g.p.m.
ft. after hrs. pumping g.p.m.
Estimated maximum yield 75 g.p.m.

13. Water sample submitted: mo./day/yr.
__ Yes X No Date

14. Well head completion:
__ Pitless adapter 12 Inches above grade

15. Well grouted? X
With: X Neat cement __ Bentonite __ Concrete
Depth: From 0 ft. to 10 ft.

16. Nearest source of possible contamination: Live Stock
ft. 60 Direction E Type
Well disinfected upon completion? __ Yes X No

17. Pump: X Not installed
Manufacturer's name
Model number HP Volts
Length of drop pipe ft. capacity g.p.m.
Type:
__ Submersible __ Turbine
__ Jet __ Reciprocating
__ Centrifugal __ Other

(Use a second sheet if needed)

18. Elevation:

Topography:
__ Hill
X Slope
__ Upland
__ Valley

19. Remarks:

20. Water well contractor's certification:
This well was drilled under my jurisdiction and this report is true to the best of my knowledge and belief. 186
Kellys Water Well Ser
Business name License No.
Address R2 Great Bend - Ks.
Signed Kelly Price Date 8-20-77
Authorized representative

23 T 13 R E/W 21 Sec CSW NW 1/4 1/4 1/4

Forward the white, blue and pink copies to the Department of Health and Environment

Form WWC-5

MI-1023