


1 LOCATION OF WATER WELL: Fraction NW 1/4 NE 1/4 NE 1/4 Section Number 30 Township Number T 23 S Range Number R 13 E/W

Distance and direction from nearest town or city street address of well if located within city?  
1-N OF ST. JOHN, KS.

2 WATER WELL OWNER: MURFIN DRILLING CO.  
RR#, St. Address, Box #: 250 N. WATER #300 Board of Agriculture, Division of Water Resources  
City, State, ZIP Code: WICHITA, KS. 67202 Application Number: 92-0132

3 LOCATE WELL'S LOCATION WITH AN "X" IN SECTION BOX:

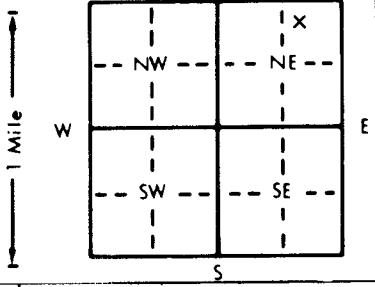

4 DEPTH OF COMPLETED WELL... 50 ft. ELEVATION:  
Depth(s) Groundwater Encountered 1. . . . . ft. 2. . . . . ft. 3. . . . . ft.  
WELL'S STATIC WATER LEVEL . . . . . 7 . . . . ft. below land surface measured on mo/day/yr  
Pump test data: Well water was . . . . . ft. after . . . . . hours pumping . . . . . gpm  
Est. Yield . . . . . gpm: Well water was . . . . . ft. after . . . . . hours pumping . . . . . gpm  
Bore Hole Diameter . . . . . 9 . . . . in. to . . . . . ft., and . . . . . in. to . . . . . ft.  
WELL WATER TO BE USED AS: 5 Public water supply 8 Air conditioning 11 Injection well  
1 Domestic 3 Feedlot  Oil field water supply 9 Dewatering 12 Other (Specify below)  
2 Irrigation 4 Industrial 7 Lawn and garden only 10 Monitoring well  
Was a chemical/bacteriological sample submitted to Department? Yes . . . . . No  . . . . . ; If yes, mo/day/yr sample was submitted  
Water Well Disinfected? Yes . . . . . No

5 TYPE OF BLANK CASING USED: 5 Wrought iron 8 Concrete tile CASING JOINTS: Glued  Clamped . . . . .  
1 Steel 3 RMP (SR) 6 Asbestos-Cement 9 Other (specify below) Welded . . . . .  
 PVC 4 ABS 7 Fiberglass . . . . . Threaded . . . . .  
Blank casing diameter . . . . . 5 . . . . in. to 40 . . . . ft., Dia . . . . in. to . . . . ft., Dia . . . . in. to . . . . ft.  
Casing height above land surface . . . . 18 . . . . in., weight . . . . lbs./ft. Wall thickness or gauge No. . . . .  
TYPE OF SCREEN OR PERFORATION MATERIAL:  7 PVC 10 Asbestos-cement  
1 Steel 3 Stainless steel 5 Fiberglass 8 RMP (SR) 11 Other (specify) . . . . .  
2 Brass 4 Galvanized steel 6 Concrete tile 9 ABS 12 None used (open hole)  
SCREEN OR PERFORATION OPENINGS ARE: 5 Gauzed wrapped 8 Saw cut 11 None (open hole)  
1 Continuous slot  Mill slot 6 Wire wrapped 9 Drilled holes  
2 Louvered shutter 4 Key punched 7 Torch cut 10 Other (specify) . . . . .  
SCREEN-PERFORATED INTERVALS: From . . . . 40 . . . . ft. to 50 . . . . ft., From . . . . ft. to . . . . ft.  
From . . . . ft. to . . . . ft., From . . . . ft. to . . . . ft.  
GRAVEL PACK INTERVALS: From . . . . 20 . . . . ft. to 50 . . . . ft., From . . . . ft. to . . . . ft.  
From . . . . ft. to . . . . ft., From . . . . ft. to . . . . ft.

6 GROUT MATERIAL: 1 Neat cement 2 Cement grout  Bentonite 4 Other . . . . .  
Grout Intervals: From . . . . 0 . . . . ft. to 20 . . . . ft., From . . . . ft. to . . . . ft., From . . . . ft. to . . . . ft.  
What is the nearest source of possible contamination:  
1 Septic tank 4 Lateral lines 7 Pit privy 10 Livestock pens 14 Abandoned water well  
2 Sewer lines 5 Cess pool 8 Sewage lagoon 11 Fuel storage 15 Oil well/Gas well  
3 Watertight sewer lines 6 Seepage pit 9 Feedyard 12 Fertilizer storage 16 Other (specify below)  
3 Insecticide storage . . . . . NONE . . . . .  
Direction from well? How many feet?

FROM	TO	LITHOLOGIC LOG	FROM	TO	PLUGGING INTERVALS
0	3	TOP SOIL			
3	8	CLAY			
8	34	GRAVEL			
34	41	CLAY			
41	50	GRAVEL			

7 CONTRACTOR'S OR LANDOWNER'S CERTIFICATION: This water well was  constructed, (2) reconstructed, or (3) plugged under my jurisdiction and was completed on (mo/day/year) 4-20-92 and this record is true to the best of my knowledge and belief. Kansas Water Well Contractor's License No. 462-B This Water Well Record was completed on (mo/day/yr) 8-19-92 under the business name of SAM'S WATER WELL SERVICE by (signature) Sara Rayburn

INSTRUCTIONS: Use typewriter or ball point pen. PLEASE PRESS FIRMLY and PRINT clearly. Please fill in blanks, underline or circle the correct answers. Send top three copies to Kansas Department of Health and Environment, Bureau of Water, Topeka, Kansas 66620-0001. Telephone: 913-296-5545. Send one to WATER WELL OWNER and retain one for your records.

OFFICE USE ONLY  
T  
R  
EW  
SEC.  
1/4  
1/4  
1/4