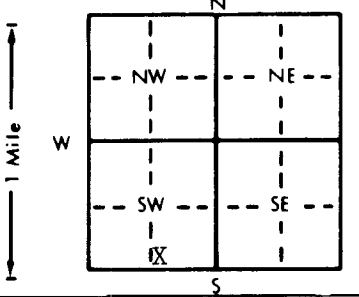


1 LOCATION OF WATER WELL:		Fraction	Section Number	Township Number	Range Number
County: <u>Stafford</u>		<u>SW 1/4 SE 1/4 SW 1/4</u>	<u>33</u>	<u>T 23 S</u>	<u>R 13W E/W</u>
Distance and direction from nearest town or city street address of well if located within city?					
<u>Downtown St. John, Kansas</u>					
2 WATER WELL OWNER: <u>Kurt Keesling</u>					
RR#, St. Address, Box # : <u>310 E 1st</u>					
City, State, ZIP Code : <u>St. John, Kansas 67576</u>					
Board of Agriculture, Division of Water Resources					
Application Number:					
3 LOCATE WELL'S LOCATION WITH AN "X" IN SECTION BOX:		4 DEPTH OF COMPLETED WELL: <u>55</u> ft. ELEVATION: <u>Unknown</u>			
		Depth(s) Groundwater Encountered <u>1. 20</u> ft. <u>2.</u> ft. <u>3.</u> ft.			
		WELL'S STATIC WATER LEVEL <u>20</u> ft. below land surface measured on mo/day/yr <u>4/4/95</u>			
		Pump test data: Well water was <u> </u> ft. after <u> </u> hours pumping <u> </u> gpm			
		Est. Yield <u>20</u> gpm: Well water was <u> </u> ft. after <u> </u> hours pumping <u> </u> gpm			
		Bore Hole Diameter <u>7 7/8</u> in. to <u>5.5</u> ft. and <u> </u> in. to <u> </u> ft.			
		WELL WATER TO BE USED AS:			
		5 Public water supply 8 Air conditioning 11 Injection well			
		1 Domestic 3 Feedlot 6 Oil field water supply 9 Dewatering 12 Other (Specify below)			
		2 Irrigation 4 Industrial <u>7 Lawn and garden only</u> 10 Monitoring well			
		Was a chemical/bacteriological sample submitted to Department? Yes <u> </u> No <u> </u> ; If yes, mo/day/yr sample was submitted			
		Water Well Disinfected? Yes <u> </u> No <u> </u>			
5 TYPE OF BLANK CASING USED:					
1 Steel 3 RMP (SR) 5 Wrought iron 8 Concrete tile CASING JOINTS: <u>Glued</u> <u> </u> Clamped <u> </u>					
2 PVC 4 ABS 6 Asbestos-Cement 9 Other (specify below) <u> </u> Welded <u> </u>					
7 Fiberglass <u> </u> Threaded <u> </u>					
Blank casing diameter <u>5</u> in. to <u>3.5</u> ft., Dia <u> </u> in. to <u> </u> ft., Dia <u> </u> in. to <u> </u> ft.					
Casing height above land surface <u>12</u> in., weight <u>2.8</u> lbs./ft. Wall thickness or gauge No. <u>Sch. 40</u>					
TYPE OF SCREEN OR PERFORATION MATERIAL:					
1 Steel 3 Stainless steel 5 Fiberglass 8 RMP (SR) 10 Asbestos-cement					
2 Brass 4 Galvanized steel 6 Concrete tile 9 ABS 11 Other (specify) <u> </u>					
12 None used (open hole)					
SCREEN OR PERFORATION OPENINGS ARE:					
1 Continuous slot 3 Mill slot 5 Gauzed wrapped 8 <u>Saw cut</u> 11 None (open hole)					
2 Louvered shutter 4 Key punched 6 Wire wrapped 9 Drilled holes					
7 Torch cut 10 Other (specify) <u> </u>					
SCREEN-PERFORATED INTERVALS: From <u>35</u> ft. to <u>55</u> ft., From <u> </u> ft. to <u> </u> ft.					
From <u> </u> ft. to <u> </u> ft., From <u> </u> ft. to <u> </u> ft.					
GRAVEL PACK INTERVALS: From <u>20</u> ft. to <u>55</u> ft., From <u> </u> ft. to <u> </u> ft.					
From <u> </u> ft. to <u> </u> ft., From <u> </u> ft. to <u> </u> ft.					
6 GROUT MATERIAL: 1 Neat cement 2 Cement grout 3 <u>Bentonite</u> 4 Other <u> </u>					
Grout intervals: From <u>0</u> ft. to <u>20</u> ft., From <u> </u> ft. to <u> </u> ft., From <u> </u> ft. to <u> </u> ft.					
What is the nearest source of possible contamination:					
1 Septic tank 4 Lateral lines 7 Pit privy 10 Livestock pens 14 Abandoned water well					
2 <u>Sewer lines Enclosed</u> 5 Cess pool 8 Sewage lagoon 11 Fuel storage 15 Oil well/Gas well					
3 Watertight sewer lines 6 Seepage pit 9 Feedyard 12 Fertilizer storage 16 Other (specify below) <u> </u>					
13 Insecticide storage <u> </u>					
Direction from well? <u>East</u> How many feet? <u>25</u>					
LITHOLOGIC LOG					
FROM	TO	PLUGGING INTERVALS			
0	7	Top soil			
7	18	Sand and gravel			
18	25	Clay			
25	55	Sand and gravel			
7 CONTRACTOR'S OR LANDOWNER'S CERTIFICATION: This water well was (1) <u>constructed</u> , (2) reconstructed, or (3) plugged under my jurisdiction and was completed on (mo/day/year) <u>4/4/95</u> and this record is true to the best of my knowledge and belief. Kansas					
Water Well Contractor's License No. <u>186</u> This Water Well Record was completed on (mo/day/yr) <u>4/5/95</u>					
under the business name of <u>Kelly's Water Well Service, Inc.</u> by (signature) <u>[Signature]</u>					
INSTRUCTIONS: Use typewriter or ball point pen. <u>PLEASE PRESS FIRMLY</u> and <u>PRINT</u> clearly. Please fill in blanks, underline or circle the correct answers. Send top three copies to Kansas Department of Health and Environment, Bureau of Water, Topeka, Kansas 66620-0001. Telephone: 913-296-5545. Send one to WATER WELL OWNER and retain one for your records.					