USE TYPEWRITER OR BALL POINT PEN-PRESS FIRMLY, PRINT CLEARLY.

WATER WELL RECORD
KSA 82a-1201-1215

Kansas Department of Health and Environment-Division of Environment
(Water well Contractors)
Topeka, Kansas 66620

Biland #1

1. Location of well:	County	Fraction	Section number	Township number	Range number
	Stafford	SE 1/4 NW 1/4 NE 1/4	1	T 23 S S	R 14W E/W

2. Distance and direction from nearest town or city: 5 north 3½ west St John
Street address of well location if in city:

3. Owner of well: Emphasis Drilling Co
R.R. or street:
City, state, zip code: Russell Kansas

4. Locate with "X" in section below: Sketch map:

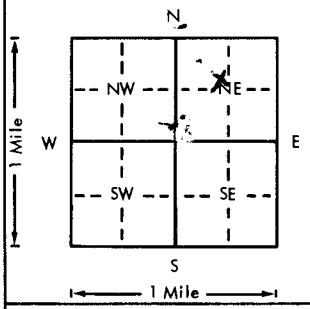

6. Bore hole dia. 8 in. Completion date
Well depth 80 ft. 9-27-77

7. __ Cable tool X Rotary __ Driven __ Dug
__ Hallow rod __ Jetted __ Bored __ Reverse rotary

8. Use: __ Domestic __ Public supply __ Industry
__ Irrigation __ Air conditioning __ Stock
__ Lawn X Oil field water __ Other

9. Casing: Material Plastic Weight: Above or below
Threaded __ Welded X Surface 12 in.
RMP __ PVC X Weight 282.3 lbs./ft.
Dia. 5 in. to 80 ft. depth Wall Thickness: inches or
Dia. __ in. to __ ft. depth gage No. 200

5. Type and color of material	From	To
Clay	0	5
Sandy Clay	5	40
Sand	40	60
Gravel	60	80
(Use a second sheet if needed)		

10. Screen: Manufacturer's name Self made
Type PVC Dia. 5
Slot gauze 15 Length 20
Set between 60 ft. and 80 ft.
ft. and ft.
Gravel pack? Yes Size range of material 1/8 - 1/4

11. Static water level: mo./day/yr.
16 ft. below land surface Date 9-27-77

12. Pumping level below land surfaces:
ft. after hrs. pumping g.p.m.
ft. ofter hrs. pumping g.p.m.
Estimated maximum yield g.p.m.

13. Water sample submitted: mo./day/yr.
__ Yes X No Date

14. Well head completion:
__ Pitless adapter Inches above grade

15. Well grouted? Yes
With: __ Neat cement X Bentonite __ Cancrete
Depth: From 0 ft. to 10 ft.

16. Nearest source of possible contamination:
ft. Direction Type
Well disinfected upon completion? __ Yes __ No

17. Pump: X Not installed
Manufacturer's name
Model number HP Volts
Length af drop pipe ft. capacity g.p.m.
Type:
__ Submersible __ Turbine
__ Jet __ Reciprocating
__ Centrifugal __ Other

18. Elevation:

Topography:
__ Hill
X Slope
__ Upland
__ Valley

19. Remarks:

20. Water well contractor's certification:
This well was drilled under my jurisdiction and this report is true to the best of my knowledge and belief.
Myers Water Well
Business Name License No.
Address Ellt Bend Ks 143
Signed A Myers Date 9-27-77
Authorized representative

T 23 R 14 E Sec 1 1/4 SE 1/4 NW 1/4 NE 1/4

Forward the white, blue and pink copies to the Department of Health and Environment

Form WWC-5

MI-1023