


1 LOCATION OF WATER WELL: County: Stafford 185		Fraction C S $\frac{1}{2}$ NE	$\frac{1}{4}$	$\frac{1}{4}$	Section Number 4	Township Number T 23 S	Range Number R 14 W	E/W
---	--	--	---------------------------------	---------------------------------	----------------------------	----------------------------------	-------------------------------	------------

Distance and direction from nearest town or city street address of well if located within city?

6 S, 2 E of Radium, Kansas

2] WATER WELL OWNER: Vernon Fox	Red Tiger Drilling	Fox B-3
RR#, St. Address, Box #: Route 1	1720 Ks. State Bank Bldg.	Dept. of Agriculture, Division of Water Resources
City, State, ZIP Code: St. John, Ks. 67576	Wichita, Ks. 67202	Application Number: 785-225- [REDACTED]

3	LOCATE WELL'S LOCATION WITH AN "X" IN SECTION BOX:	4	DEPTH OF COMPLETED WELL: 78	ft.	ELEVATION: Unknown
---	--	---	-----------------------------	-----	--------------------

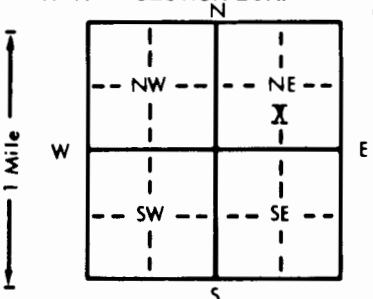

4) DEPTH OF COMPLETED WELL.....78..... ft. ELEVATION:.....Unknown.....

Depth(s) Groundwater Encountered 1. 30..... ft. 2. ft. 3. ft.

WELL'S STATIC WATER LEVEL30..... ft. below land surface measured on mo/day/yr2/27/85.....

Pump test data: Well water was ft. after hours pumping gpm

Est. Yield60..... gpm: Well water was ft. after hours pumping gpm

Bore Hole Diameter8..... in. to 78..... ft., and in. to ft.

WELL WATER TO BE USED AS:

1 Domestic	3 Feedlot	6 <u>Oil field water supply</u>	9 Dewatering	12 Other (Specify below)
2 Irrigation	4 Industrial	7 Lawn and garden only	10 Observation well	

Was a chemical/bacteriological sample submitted to Department? Yes.....No.....; If yes, mo/day/yr sample was submitted.....

Water Well Disinfected? Yes.....No.....

5 TYPE OF BLANK CASING USED:		5 Wrought iron	8 Concrete tile	CASING JOINTS: <u>Glued</u> Clamped	
1 Steel	3 RMP (SR)	6 Asbestos-Cement	9 Other (specify below)	Welded	
2 <u>PVC</u>	4 ABS	7 Fiberglass		Threaded	
Blank casing diameter . 5 in. to . 58 ft., Dia in. to ft., Dia in. to ft.					
Casing height above land surface 12 in. weight 2.8 lbs./ft. Wall thickness or gauge No. Sch. 40					

TYPE OF SCREEN OR PERFORATION MATERIAL:			7 <u>PVC</u>	10 Asbestos-cement
1 Steel	3 Stainless steel	5 Fiberglass	8 <u>RMP (SR)</u>	11 Other (specify)
2 Brass	4 Galvanized steel	6 Concrete tile	9 ABS	12 None used (open hole)

SCREEN OR PERFORATION OPENINGS ARE:

1 Continuous slot	3 Mill slot	5 Gauzed wrapped	8 <u>Saw cut</u>	11 None (open hole)
2 Louvered shutter	4 Key punched	6 Wire wrapped	9 Drilled holes	
		7 Torch cut	10 Other (specify)	

SCREEN-PERFORATED INTERVALS: From 58 ft. to 78 ft., From ft. to ft.
From ft. to ft., From ft. to ft.
GRAVEL PACK INTERVALS: From 10 ft. to 78 ft., From ft. to ft.
From ft. to ft. From ft. to ft.

6] GROUT MATERIAL: 1 Neat cement 2 Cement grout 3 Bentonite 4 Other
Grout Intervals: From 0 ft. to 10 ft. From ft. to ft. From ft. to ft.

What is the nearest source of possible contamination:

1 Septic tank	4 Lateral lines	7 Pit privy	10 Livestock pens	14 Abandoned water well
2 Sewer lines	5 Cess pool	8 Sewage lagoon	11 Fuel storage	15 <u>Oil well/Gas well</u>
3 Watertight sewer lines	6 Seepage pit	9 Feedyard	12 Fertilizer storage	16 Other (specify below)
			13 Insecticide storage	

Direction from well? South How many feet? 60

[illegible]

7 CONTRACTOR'S OR LANDOWNER'S CERTIFICATION: This water well was (1) constructed, (2) reconstructed, or (3) plugged under my jurisdiction and was completed on (mo/day/year) 2/27/85 and this record is true to the best of my knowledge and belief. Kansas Water Well Contractor's License No. 186 This Water Well Record was completed on (mo/day/yr) 3/29/85 under the business name of Kelly's Water Well Service by (signature) [Signature]

INSTRUCTIONS: Use typewriter or ball point pen, PLEASE PRESS FIRMLY and PRINT clearly. Please fill in blanks, underline or circle the correct answers. Send top three copies to Kansas Department of Health and Environment, Division of Environment, Environmental Geology Section, Topeka, KS 66620. Send one to WATER WELL OWNER and retain one for your records.