

USE TYPEWRITER OR BALL POINT PEN-PRESS FIRMLY, PRINT CLEARLY.

T R EW sec 1/4 1/4 1/4 No.


WATER WELL RECORD
KSA 82a-1201-1215

Kansas State Dept. Of Health
(Water Well Contractors)
Forbes-Bldg. 740
Topeka, Kansas 66620

1 Location of well:	County Stafford	Township name Cleveland	Fraction CNW$\frac{1}{4}$	Section number 8	Town number T23S	Range number R14W
---------------------	---------------------------	-----------------------------------	--	----------------------------	----------------------------	-----------------------------

Distance and direction from nearest town or city:
7 mi. South of Radium, Kansas
Street address of well location if in city:

3 Owner of well: **Burton Snyder**
Address: **St. John, Kansas**

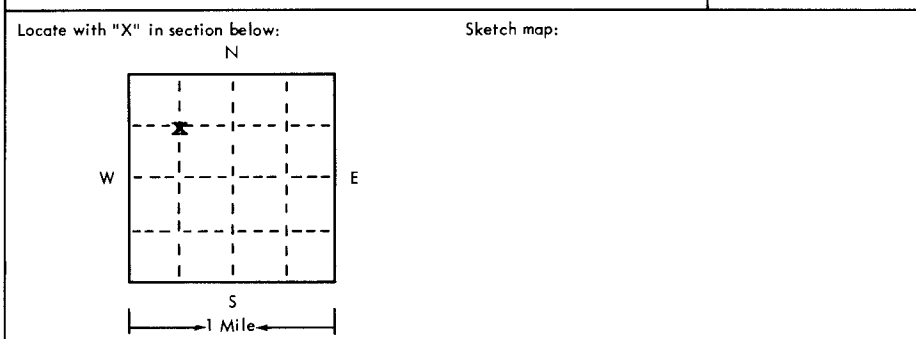

4 Well depth: 67 ft. Date of completion 7-7-75
Well diameter 24 in.

5 Cable tool Rotary Driven Dug
 Hollow rod Jetted Bored Reverse rotary

6 Use: Domestic Public supply Industry
 Irrigation Air conditioning Commercial
 Test well

7 Casing: Material Steel Height: above below
Threaded Welded Surface 12 in.
Diam. 16 in. Weight 30.3 lbs./ft.
16 in. to 38 ft. depth Drive shoe? Yes No
_____ in. to _____ ft. depth!

2	Type and color of material	From	To
	Sandy top soil	0	4
	Gray & brown clay	4	17
	Sand & fine gravel	17	27
	Soft brown clay	27	62
	Sand & gravel	62	66
	Dakota clay	66	67
SCREEN RECORD:			
	Doerr Double-slot	38	58
	Johnson .125 Irrigator	58	63
	Doerr Double-slot	63-67	
(use a second sheet if needed)			

8 Screen:
Manufacturer SEE AT LEFT
Type SEE AT LEFT Dia. 16"
Slot gauge 1/8 Length 29'
Set between _____ ft. and _____ ft.
Fittings: Gravel pack Yes No Size range of material 3/8- 200

9 Static water level:
7 ft. below land surface Date 7-7-75

10 Pumping level below land surfaces: N/C
_____ ft. after _____ hrs. pumping _____ g.p.m.
_____ ft. after _____ hrs. pumping _____ g.p.m.
Estimated maximum yield _____ g.p.m.

11 Water sample submitted:
 Yes No Date _____

12 Well head completion:
 Pitless adapter 12 inches above grade

13 Well grouted? Yes No
 Neat cement Bentonite _____
Depth: From 0 ft. to 10 ft.

14 Nearest source of possible contamination:
ft. _____ Direction _____ Type _____
Well disinfected upon completion? Yes No

15 Pump: Not installed
Manufacturer's name _____
Model number _____ HP _____ Valts _____
Length of drop pipe _____ ft. capacity _____ g.m.p.
Type:
 Submersible Turbine
 Jet Reciprocating
 Centrifugal Other

16 Remarks: elevation

Tapography:
 Hill
 Slope
 Upland
 Valley

17 Water well contractor's certification:
This well was drilled under my jurisdiction and this report is true to the best of my knowledge and belief.
Clarke Well & Eq., Inc. 185
Business name License No.
Address Great Bend, KS
Signed [Signature] Date 7-7-75
Authorized representative