USE TYPEWRITER OR BALL POINT PEN-PRESS FIRMLY, PRINT CLEARLY.

WATER WELL RECORD
KSA 82a-1201-1215

Kansas Department of Health and Environment-Division of Environment
(Water well Contractors)
Topeka, Kansas 66620

1. Location of well:	County	Fraction	Section number	Township number	Range number
	Stafford	NE 1/4 NE 1/4 NE 1/4	11	T 23 S	R 14 E/W

2. Distance and direction from nearest town or city: 4th st rd and 281 hyway 4 wes
Street address of well location if in city: 1 North

3. Owner of well: Emphasis-Oil Co
R.R. or street:
City, state, zip code: Russell Kansas

4. Locate with "X" in section below:

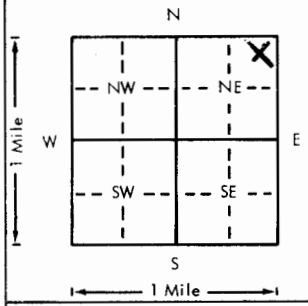

Sketch map:

X Bore hole dia. 9 in. Completion date
Well depth 62 ft. 8-3-78

7. __ Cable tool X Rotary __ Driven __ Dug
__ Hollow rod __ Jetted __ Bored __ Reverse rotary

8. Use: __ Domestic __ Public supply __ Industry
__ Irrigation __ Air conditioning __ Stock
__ Lawn X Oil field water __ Other

9. Casing: Material
Threaded ___ Welded X
RMP ___ PVC X
Dia. 5 in. to 62 ft. depth
Dia. ___ in. to ___ ft. depth
Height: Above or below Surface 12 in.
Weight 275.3 lbs./ft.
Wall Thickness: inches or gage No. 200

5. Type and color of material	From	To
Fine Sand	0	20
Clay	20	40
Gravel	40	62

(Use a second sheet if needed)

10. Screen: Manufacturer's name Shop Made
Type Saw Dia. 5
Slot/gauze 1/8 Length 20
Set between 42 ft. and 42 ft.
ft. and ft.
Gravel pack? yes Size range of material 1/8-1/4

11. Static water level: mo./day/yr.
22 ft. below land surface Date 8-3-78

12. Pumping level below land surfaces:
ft. after hrs. pumping g.p.m.
ft. after hrs. pumping g.p.m.
Estimated maximum yield g.p.m.

13. Water sample submitted: mo./day/yr.
__ Yes X No Date

14. Well head completion:
__ Pitless adapter 12 Inches above grade

15. Well grouted? yes
With: __ Neat cement X Bentonite __ Concrete
Depth: From 12 ft. to 32 ft.

16. Nearest source of possible contamination:
ft. Direction Type
Well disinfected upon completion? Yes No

17. Pump: X Not installed
Manufacturer's name
Model number HP Volts
Length of drop pipe ft. capacity g.p.m.
Type:
__ Submersible __ Turbine
__ Jet __ Reciprocating
__ Centrifugal __ Other

18. Elevation:
Topography:
__ Hill
X Slope
__ Upland
__ Valley

19. Remarks:

20. Water well contractor's certification:
This well was drilled under my jurisdiction and this report is true to the best of my knowledge and belief.
Business name Myers Water Well License No. 143
Address Gt Bend Ks
Signed Hugh Rosendahl Date 8-3-78
Authorized representative

23 T 14 R E/W 11 Sec NE NE 1/4 1/4 1/4

Forward the white, blue and pink copies to the Department of Health and Environment

Form WWC-5

MI-1023