USE TYPEWRITER OR BALL POINT PEN-PRESS FIRMLY, PRINT CLEARLY.

WATER WELL RECORD
KSA 82a-1201-1215

Kansas Department of Health and Environment-Division of Environment
(Water well Contractors)
Topeka, Kansas 66620

1. Location of well:	County	Fraction	Section number	Township number	Range number
	Stafford	se 1/4 sw 1/4 sw 1/4	24	T 23 S	R 14 E/W

2. Distance and direction from nearest town or city: 1 mi North 2½ mi. west of St John, Ks.
Street address of well location if in city:

3. Owner of well: B & N Drilling Co.
R.R. or street: Box 846
City, state, zip code: Independence, Ks. 67301

4. Locate with "X" in section below: Sketch map:

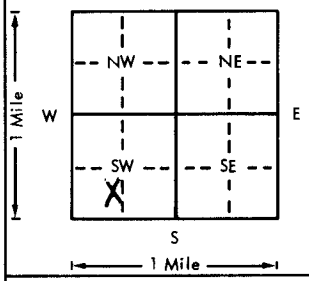

6. Bore hole dia. 9 7/8 in. Completion date
Well depth 90 ft. 5-10-77

7. __ Cable tool X Rotary __ Driven __ Dug
__ Hollow rad __ Jetted __ Bored __ Reverse ratary

8. Use: __ Domestic __ Public supply X Industry
__ Irrigation __ Air conditioning __ Stock
__ Lawn __ Oil field water __ Other

9. Casing: Material ~~pvc~~ Height: Above or below
Threaded __ Welded X Surface 18 in.
RMP __ PVC __ Weight 160 lbs./ft.
Dia. 4 in. to 90 ft. depth Wall Thickness: inches or
Dia. __ in. to __ ft. depth gage No. ~~SCH~~ 237

5. Type and color of material	From	To
Sandy top soil	0	2
Sandy clay	2	18
Sandy clay some gravel	18	27
Sand and gravel clay mixed	27	42
Sand and gravel	42	86
Clay	86	90
(Use a second sheet if needed)		

10. Screen: Manufacturer's name Certainteen
Type pvc Dia. 4
Slot/gauge 1/16 Length 20
Set between 70 ft. and 90 ft.
ft. and ft.
Gravel pack? X Size range of material 3/4-3/8-½

11. Static water level: mo./day/yr.
32 ft. below land surface Date 5-10-77

12. Pumping level below land surfaces:
ft. after hrs. pumping g.p.m.
ft. after hrs. pumping g.p.m.
Estimated maximum yield g.p.m.

13. Water sample submitted: mo./day/yr.
__ Yes X No Date

14. Well head completion:
__ Pitless adapter Inches above grade

15. Well grouted? no
With: __ Neat cement __ Bentonite __ Concrete
Depth: From ft. to ft.

16. Nearest source of possible contamination:
ft. 70 Direction south Type oil well
Well disinfected upon completion? __ Yes no No

17. Pump: X Not installed
Manufacturer's name
Model number HP Volts
Length of drop pipe ft. capacity g.p.m.
Type:
__ Submersible __ Turbine
__ Jet __ Reciprocating
__ Centrifugal __ Other

18. Elevation:
Topography:
__ Hill
__ Slope
X Upland
__ Valley

19. Remarks:
well will be pulled & plugged with well cuttings & gravel pack.

20. Water well contractor's certification:
This well was drilled under my jurisdiction and this report is true to the best of my knowledge and belief.
Rosencrantz Bemis 134
Business name License No.
Address Great Bend, Ks.
Signed Sandy Kilpoe Date 6-16
Authorized representative

T 23 R 14 E W Sec 24 SE SW SW 1/4 1/4 1/4

Forward the white, blue and pink copies to the Department of Health and Environment

Form WWC-5

MI-1023