USE TYPEWRITER OR BALL POINT PEN-PRESS FIRMLY, PRINT CLEARLY.

WATER WELL RECORD
KSA 82a-1201-1215

Kansas Department of Health and Environment-Division of Environment
(Water well Contractors)
Topeka, Kansas 66620

1. Location of well:	County	Fraction	Section number	Township number	Range number
X	Stafford	1/4 C 1/4 NW 1/4	28	T 23 S	R 14 E (W)

2. Distance and direction from nearest town or city:
~~2 W 3 3/4 N~~ of St. John, Ks.
Street address of well location if in city:
5½-W 1¾-N

3. Owner of well: Burton Snyder
R.R. or street: Rt. 3
City, stote, zip code: St. John, Ks. 67576

4. Locate with "X" in section below:

Sketch map:

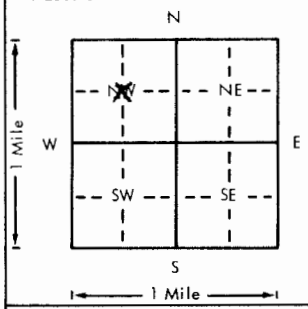

6. Bore hole dia. 29 in. Completion date
Well depth 64 ft. 11-7-77

7. __ Cable tool X Rotary __ Driven __ Dug
__ Hollow rod __ Jetted __ Bored __ Reverse rotary

8. Use: __ Domestic __ Public supply __ Industry
X Irrigation __ Air conditioning __ Stock
__ Lawn __ Oil field water __ Other

9. Casing: Material steel Height: Above or below
Threaded ___ Welded ___ Surface 18 in.
RMP ___ PVC ___ Weight ___ lbs./ft.
Dia. 16 in. to 64 ft. depth Wall Thickness: inches or
Dia. ___ in. to ___ ft. depth gage No. 7

5. Type and color of material	From	To
sandy top soil	0	3
brown clay	3	11
yellow ~~bor~~ brown sandy clay	11	17
fine sand & clay	17	30
light brown & white clay	30	35
sand & gravel fine to med.	35	40
sand & gravel med. to loose	40	45
sand & gravel clean coarse loose	45	64
brown & white clay	64	75
(Use a second sheet if needed)		

10. Screen: Manufacturer's name
8' Doerrs & 10' Johnson
Type ___ Dia. ___
Slot ~~Gage~~ 3/16 Length 18
Set between 46 ft. and 64 ft.
___ ft. and ___ ft.
Gravel pack? X Size range of material 3/4 3/8

11. Static water level: mo./day/yr.
20 ft. below land surface Date 10-17-77

12. Pumping level below land surfaces:
39 ft. after 1 hrs. pumping 400 g.p.m.
___ ft. after ___ hrs. pumping ___ g.p.m.
Estimated maximum yield 650 g.p.m.

13. Water sample submitted: mo./day/yr.
X Yes ___ No Date 10-17-77

14. Well head completion:
___ Pitless adapter ___ Inches above grade

15. Well grouted? X
With: X Neat cement ___ Bentonite ___ Concrete
Depth: From 0 ft. to 10 ft.

16. Nearest source of possible contamination:
ft. 1000 Direction west Type septic
Well disinfected upon completion? X Yes ___ No

17. Pump: X Not installed
Manufacturer's name ___
Model number ___ HP ___ Volts ___
Length of drop pipe ___ ft. capacity ___ g.p.m.
Type:
___ Submersible ___ Turbine
___ Jet ___ Reciprocating
___ Centrifugal ___ Other

T 23 R 14 E (W) Sec 28 1/4 C 1/4 NW 1/4

18. Elevation:

Topography:
___ Hill
___ Slope
X Upland
___ Valley

19. Remarks:

20. Water well contractor's certification:
This well was drilled under my jurisdiction and this report is true to the best of my knowledge and belief.
Rosancrantz-Bemis 134
Business name License No.
Address Great Bend, Ks. 67530
Signed Sandy Kilgore Date 11-19-77
Authorized representative

Forward the white, blue and pink copies to the Department of Health and Environment

Form WWC-5

MI-1023