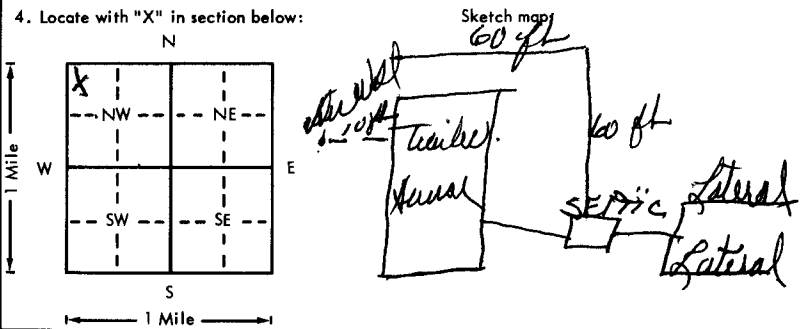


USE TYPEWRITER OR BALL
POINT PEN-PRESS FIRMLY,
PRINT CLEARLY.

WATER WELL RECORD
KSA 82a-1201-1215

Kansas Department of Health and
Environment-Division of Environment
(Water well Contractors)
Topeka, Kansas 66620

1. Location of well: County <u>Shawnee</u> Fraction <u>N 1/4</u> <u>1/4</u> <u>NE 1/4</u> Section number <u>12</u> Township number <u>T 23</u> Range number <u>S 15</u> <u>1/4</u>	
2. Distance and direction from nearest town or city: Street address of well location if in city: <u>8 South Nodum St Wash</u>	
3. Owner of well: <u>Chris Ringstone</u> R.R. or street: <u>5306 N 5th St</u> City, state, zip code: <u>Andover, KS 66001</u>	
4. Locate with "X" in section below: 	
5. Type and color of material	
From To	
<u>Sandy soil</u> 0 10	
<u>Clay</u> 10 30	
<u>Sandy clay</u> 30 48	
<u>gravel</u> 48 60	
6. Bore hole dia. <u>8</u> in. Completion date <u>10-12-76</u> Well depth <u>60</u> ft.	
7. <input checked="" type="checkbox"/> Cable tool <input checked="" type="checkbox"/> Rotary <input type="checkbox"/> Driven <input type="checkbox"/> Dug <input type="checkbox"/> Hollow rod <input type="checkbox"/> Jetted <input type="checkbox"/> Bored <input type="checkbox"/> Reverse rotary	
8. Use: <input checked="" type="checkbox"/> Domestic <input type="checkbox"/> Public supply <input type="checkbox"/> Industry <input type="checkbox"/> Irrigation <input type="checkbox"/> Air conditioning <input type="checkbox"/> Stock <input type="checkbox"/> Lawn <input type="checkbox"/> Oil field water <input type="checkbox"/> Other	
9. Casing: Material <u>VE</u> Height: Above or below Threaded <u>steel</u> Surface <u>12</u> in. RMP <u>PVC</u> Weight <u>2673</u> lbs./ft. Dia. <u>4</u> in. to <u>60</u> ft. depth Wall Thickness: inches or Dia. <u>4</u> in. to <u>60</u> ft. depth gage No. <u>40</u>	
10. Screen: Manufacturer's name <u>Shawnee</u> Type <u>Shawnee</u> Dia. <u>40</u> Size <u>1/2</u> in. Length <u>10</u> Set between <u>50</u> ft. and <u>60</u> ft. Gravel pack? <input checked="" type="checkbox"/> Size range of material <u>8-14</u>	
11. Static water level: <u>19</u> ft. below land surface Date <u>10-12-76</u> mo./day/yr.	
12. Pumping level below land surfaces: <u>21</u> ft. after <u>1</u> hrs. pumping <u>80</u> g.p.m. <u>21</u> ft. after <u>1</u> hrs. pumping <u>80</u> g.p.m. Estimated maximum yield <u>160</u> g.p.m.	
13. Water sample submitted: <u>10-12-76</u> mo./day/yr. <input type="checkbox"/> Yes <input checked="" type="checkbox"/> No Date	
14. Well head completion: <input checked="" type="checkbox"/> Pitless adapter <u>12</u> inches above grade	
15. Well grouted? <input checked="" type="checkbox"/> With: <input checked="" type="checkbox"/> Neat cement <input type="checkbox"/> Bentonite <input type="checkbox"/> Concrete Depth: From <u>5</u> ft. to <u>15</u> ft.	
16. Nearest source of possible contamination: ft. <u>100</u> Direction <u>NE</u> Type <u>Septic</u> Well disinfected upon completion? <input checked="" type="checkbox"/> Yes <input type="checkbox"/> No	
17. Pump: <u>Not installed</u> Manufacturer's name <u>Shawnee</u> Model number <u>DM-50</u> HP <u>1/2</u> Volts <u>230</u> Length of drop pipe <u>35</u> ft. capacity <u>620</u> g.p.m. Type: <input checked="" type="checkbox"/> Submersible <input type="checkbox"/> Turbine <input type="checkbox"/> Jet <input type="checkbox"/> Reciprocating <input type="checkbox"/> Centrifugal <input type="checkbox"/> Other	
(Use a second sheet if needed)	
18. Elevation: Topography: <input type="checkbox"/> Hill <input checked="" type="checkbox"/> Slope <input type="checkbox"/> Upland <input type="checkbox"/> Valley	19. Remarks: <u>Customer will test water at later date.</u>
20. Water well contractor's certification: This well was drilled under my jurisdiction and this report is true to the best of my knowledge and belief. Business name <u>Shawnee</u> License No. <u>173</u> Address <u>Andover, KS</u> Signed <u>Shawnee</u> Date <u>10-12-76</u> Authorized representative	

Forward the white, blue and pink copies to the Department of Health and Environment

Form WWC-5