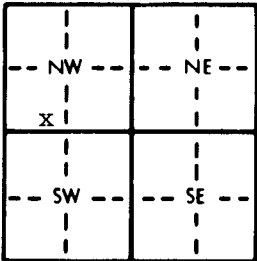
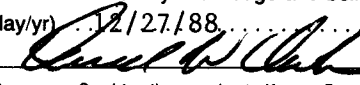


1 LOCATION OF WATER WELL:		Fraction		Section Number		Township Number		Range Number	
County: Pawnee		SE 1/4 SW 1/4 NW 1/4		30		T 23 S		R 15 EW	
Distance and direction from nearest town or city street address of well if located within city? Approximately 3 3/4 East & 2 1/2 South of Zook KS	
2 WATER WELL OWNER: Kansas Corporation Commission	
RR#, St. Address, Box # : 302 West McArtot Road Board of Agriculture, Division of Water Resources	
City, State, ZIP Code : Dodge City, KS 67801 Application Number: N/A	
3 LOCATE WELL'S LOCATION WITH AN "X" IN SECTION BOX:		4 DEPTH OF COMPLETED WELL: 110 ft. ELEVATION: unknown	
		Depth(s) Groundwater Encountered 1. N/C ft. 2. ft. 3. ft.	
		WELL'S STATIC WATER LEVEL N/C ft. below land surface measured on mo/day/yr	
		Pump test data: Well water was not ch'd ft. after hours pumping gpm	
		Est. Yield unknown gpm: Well water was ft. after hours pumping gpm	
		Bore Hole Diameter 6 in. to 110 ft., and in. to ft.	
WELL WATER TO BE USED AS: 5 Public water supply 8 Air conditioning 11 Injection well	
1 Domestic 3 Feedlot 6 Oil field water supply 9 Dewatering 12 Other (Specify below)	
2 Irrigation 4 Industrial 7 Lawn and garden only 10 Monitoring well	
Was a chemical/bacteriological sample submitted to Department? Yes. No. x; If yes, mo/day/yr sample was submitted	
Water Well Disinfected? Yes x No	
5 TYPE OF BLANK CASING USED:	
1 Steel 3 RMP (SR) 6 Asbestos-Cement 9 Other (specify below) CASING JOINTS: Glued Clamped	
2 PVC 4 ABS 7 Fiberglass Welded	
Blank casing diameter 2 in. to 77 ft., Dia. in. to ft., Dia. in. to ft.	
Casing height above land surface 24 in., weight 427 lbs./ft. Wall thickness or gauge No. 091	
TYPE OF SCREEN OR PERFORATION MATERIAL:	
1 Steel 3 Stainless steel 5 Fiberglass 8 RMP (SR) 10 Asbestos-cement	
2 Brass 4 Galvanized steel 6 Concrete tile 9 ABS 11 Other (specify)	
12 None used (open hole)	
SCREEN OR PERFORATION OPENINGS ARE:	
1 Continuous slot 5 Gauzed wrapped 8 Saw cut 11 None (open hole)	
2 Louvered shutter 3 Mill slot 6 Wire wrapped 9 Drilled holes	
4 Key punched 7 Torch cut 10 Other (specify)	
SCREEN-PERFORATED INTERVALS: From 77 ft. to 87 ft., From ft. to ft.	
From ft. to ft., From ft. to ft.	
GRAVEL PACK INTERVALS: From 73 ft. to 110 ft., From ft. to ft.	
From ft. to ft., From ft. to ft.	
6 GROUT MATERIAL: 1 Neat cement 2 Cement grout 3 Bentonite 4 Other Bentonite "Holeplug"	
Grout Intervals: From ft. to ft., From 0 ft. to 73 ft., From 90 ft. to 91 ft.	
What is the nearest source of possible contamination:	
1 Septic tank 4 Lateral lines 7 Pit privy 10 Livestock pens 14 Abandoned water well	
2 Sewer lines 5 Cess pool 8 Sewage lagoon 11 Fuel storage 15 Oil well/Gas well	
3 Watertight sewer lines 6 Seepage pit 9 Feedyard 12 Fertilizer storage 16 Other (specify below)	
13 Insecticide storage Sinkhole	
Direction from well? How many feet?	
<table border="1" style="width:100%; border-collapse: collapse;"><thead><tr><th>FROM</th><th>TO</th><th>LITHOLOGIC LOG</th><th>FROM</th><th>TO</th><th>PLUGGING INTERVALS</th></tr></thead><tbody><tr><td>0</td><td>8</td><td>Topsoil Fine sand</td><td></td><td></td><td></td></tr><tr><td>8</td><td>22</td><td>Clay Brown & Gray</td><td></td><td></td><td></td></tr><tr><td>22</td><td>27</td><td>Sand Fine</td><td></td><td></td><td></td></tr><tr><td>27</td><td>40</td><td>Clay Sandy Brown</td><td></td><td></td><td></td></tr><tr><td>40</td><td>60</td><td>Sand & Gravel-fine-med w/ clay streak @ 52'</td><td></td><td></td><td></td></tr><tr><td>60</td><td>87</td><td>Sand & Gravel-fine-med w/tan clay streaks @ 80' & 84'</td><td></td><td></td><td></td></tr><tr><td>87</td><td>92</td><td>Clay white & tan w/hard cemented streak @ 87</td><td></td><td></td><td></td></tr><tr><td>92</td><td>95</td><td>Alluvial-drift reworked dakota sandstone fine sand & gravel, clay miced tight</td><td></td><td></td><td></td></tr><tr><td>95</td><td>101</td><td>clay white & Tan</td><td></td><td></td><td></td></tr><tr><td>101</td><td>104</td><td>Alluvial-drift reworked dakota sandstone sand & gravel Loose</td><td></td><td></td><td></td></tr><tr><td>104</td><td>110</td><td>Clay yellow & white</td><td></td><td></td><td></td></tr>
7 CONTRACTOR'S OR LANDOWNER'S CERTIFICATION: This water well was (1) constructed, (2) reconstructed, or (3) plugged under my jurisdiction and was completed on (mo/day/year) 10/20/88 and this record is true to the best of my knowledge and belief. Kansas Water Well Contractor's License No. 185 This Water Well Record was completed on (mo/day/yr) 12/27/88 under the business name of Clarke Well & Equipment Inc. by (signature) 	
INSTRUCTIONS: Use typewriter or ball point pen. PLEASE PRESS FIRMLY and PRINT clearly. Please fill in blanks, underline or circle the correct answers. Send top three copies to Kansas Department of Health and Environment, Bureau of Water Protection, Topeka, Kansas 66620-7320. Telephone: 913-296-5514. Send one to WATER WELL OWNER and retain one for your records.	

OFFICE USE ONLY

T

23

R

15

EW

SEC. 30

1/4

1/4

1/4