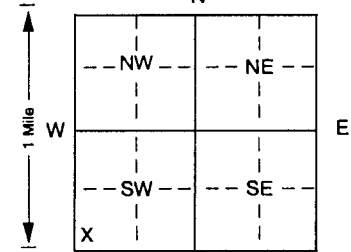


1 LOCATION OF WATER WELL:		Fraction	Section Number	Township Number	Range Number
County: Pawnee		SW 1/4 SW 1/4 SW 1/4	36	T 23 S	R 16 E
Distance and direction from nearest town or city street address of well if located within city?					
Approximately 4 miles west and 3 miles north of Macksville					
2 WATER WELL OWNER: Darrell Wood					
RR#, St. Address, Box # : Route 1 - Box 120			Board of Agriculture, Division of Water Resources		
City, State, ZIP Code : Lewis, KS 67552			Application Number: 17,560		
3 LOCATE WELL'S LOCATION WITH AN "X" IN SECTION BOX:		4 DEPTH OF COMPLETED WELL 85.4 ft. ELEVATION: unknown			
		Depth(s) Groundwater Encountered 1 ft. 2 ft. 3 ft.			
		WELL'S STATIC WATER LEVEL 34 ft. below land surface measured on mo/day/yr 5-20-04			
		Pump test data: Well water was not checked ft. after hours pumping gpm			
		Est. Yield unknown gpm: Well water was ft. after hours pumping gpm			
		Bore Hole Diameter 30 in. to 84 ft., and in. to ft.			
		WELL WATER TO BE USED AS: 5 Public water supply 8 Air conditioning 11 Injection well			
		1 Domestic 3 Feedlot 6 Oil field water supply 9 Dewatering 12 Other (specify below)			
		(2) Irrigation 4 Industrial 7 Domestic (lawn & garden) 10 Monitoring well			
		Was a chemical/bacteriological sample submitted to Department? Yes No If yes, mo/day/yr sample was submitted			
		Water Well Disinfected? Yes No			
5 TYPE OF BLANK CASING USED:					
(1) Steel 3 RMP (SR)		5 Wrought iron 8 Concrete tile		CASING JOINTS: Glued Clamped	
(2) PVC 4 ABS		6 Asbestos-Cement 9 Other (specify below)		Welded	
		7 Fiberglass		Threaded	
Blank casing diameter 16 (PVC) in. to 56 ft., Dia 16 (Steel) in. to 83.4 ft., Dia in. to ft.					
Casing height above land surface 24 in., weight 16.15 lbs./ft. Wall thickness or gauge No .500					
TYPE OF SCREEN OR PERFORATION MATERIAL:					
1 Steel (3) Stainless steel 5 Fiberglass 8 RMP (SR)		7 PVC 10 Asbestos-cement		11 Other (specify)	
2 Brass 4 Galvanized steel 6 Concrete tile 9 ABS				12 None used (open hole)	
SCREEN OR PERFORATION OPENINGS ARE:					
(1) Continuous slot 3 Mill slot 5 Gauzed wrapped 8 Saw cut 11 None (open hole)		6 Wire wrapped 9 Drilled holes			
2 Louvered shutter 4 Key punched 7 Torch cut 10 Other (specify)					
SCREEN-PERFORATED INTERVALS: From 56 ft. to 81.4 ft., From ft. to ft.					
GRAVEL PACK INTERVALS: From 30 ft. to 84 ft., From ft. to ft.					
6 GROUT MATERIAL: 1 Neat cement (2) Cement grout 3 Bentonite Sand 4 Other					
Grout Intervals: From 0 ft. to 21 ft., From 21 ft. to 30 ft., From ft. to ft.					
What is the nearest source of possible contamination:					
1 Septic tank 4 Lateral lines 7 Pit privy 10 Livestock pens 14 Abandoned water well		11 Fuel storage 15 Oil well/Gas well			
2 Sewer lines 5 Cess pool 8 Sewage lagoon 12 Fertilizer storage 16 Other (specify below)		13 Insecticide storage None known			
3 Watertight sewer lines 6 Seepage pit 9 Feedyard					
Direction from well? How many feet?					
FROM	TO	LITHOLOGIC LOG	FROM	TO	PLUGGING INTERVALS
0	4	Topsoil			
4	10	Clay, gray, sandy			
10	25	Clay, brown, sandy			
25	36	Clay, brown, hard			
36	42	Sand, fine			
42	50	Sand and gravel, fine, medium			
50	81	Sand and gravel, fine, medium, coarse			
81	84	Clay, tan, hard			
7 CONTRACTOR'S OR LANDOWNER'S CERTIFICATION: This water well was (1) constructed (2) reconstructed or (3) plugged under my jurisdiction and was completed on (mo/day/year) 5-20-04 and this record is true to the best of my knowledge and belief. Kansas Water Well Contractor's License No 185 This Water Well Record was completed on (mo/day/yr) 6-10-04 under the business name of Clarke Well & Equipment, Inc. by (signature)					
INSTRUCTIONS: Use typewriter or ball point pen. PLEASE PRESS FIRMLY and PRINT clearly. Please fill in blanks, underline or circle the correct answers. Send top three copies to Kansas Department of Health and Environment, Bureau of Water, Topeka, Kansas 66620-0001. Telephone 785-296-5524. Send one to WATER WELL OWNER and retain one for your records. Fee of \$5.00 for each constructed well.					