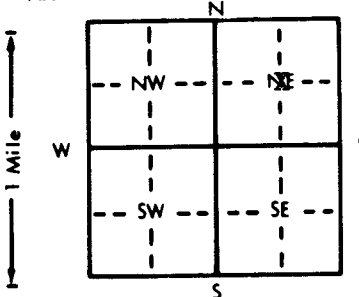


1 LOCATION OF WATER WELL:		Fraction	Section Number	Township Number	Range Number
County: Pawnee		C 1/4 NE 1/4 1/4	12	T 23 S	R 16W E/W
Distance and direction from nearest town or city street address of well if located within city?					
1 N, 4 E of Zook, Kansas					
2 WATER WELL OWNER: Carl Martin					
RR#, St. Address, Box #: 110 College Avenue			Board of Agriculture, Division of Water Resources		
City, State, ZIP Code: Winfield, Ks. 67156			Application Number: 26598		
3 LOCATE WELL'S LOCATION WITH AN "X" IN SECTION BOX:		4 DEPTH OF COMPLETED WELL: 66 ft. ELEVATION: Unknown			
		Depth(s) Groundwater Encountered 1. 18 ft. 2. ft. 3. ft.			
		WELL'S STATIC WATER LEVEL 18 ft. below land surface measured on mo/day/yr 3/23/92			
		Pump test data: Well water was 60 ft. after 3 hours pumping 650 gpm			
		Est. Yield gpm: Well water was ft. after hours pumping gpm			
Bore Hole Diameter 30 in. to 66 ft. and in. to ft.		WELL WATER TO BE USED AS:			
1 Domestic 3 Feedlot 6 Oil field water supply 9 Dewatering 12 Other (Specify below)		5 Public water supply 8 Air conditioning 11 Injection well			
2 Irrigation 4 Industrial 7 Lawn and garden only 10 Monitoring well		Was a chemical/bacteriological sample submitted to Department? Yes No; If yes, mo/day/yr sample was submitted			
5 TYPE OF BLANK CASING USED:		CASING JOINTS: Glued Clamped			
1 Steel 3 RMP (SR) 6 Asbestos-Cement 9 Other (specify below) Welded		2 PVC 4 ABS 7 Fiberglass Threaded			
Blank casing diameter 16 in. to 41 ft. Dia. in. to ft. Dia. in. to ft.		Casing height above land surface 12 in., weight 16.5 lbs./ft. Wall thickness or gauge No. Sch. 40			
TYPE OF SCREEN OR PERFORATION MATERIAL:		7 PVC 10 Asbestos-cement			
1 Steel 3 Stainless steel 5 Fiberglass 8 RMP (SR) 11 Other (specify)		2 Brass 4 Galvanized steel 6 Concrete tile 9 ABS 12 None used (open hole)			
SCREEN OR PERFORATION OPENINGS ARE:		5 Gauzed wrapped 8 Saw cut 11 None (open hole)			
1 Continuous slot 3 Mill slot 6 Wire wrapped 9 Drilled holes		2 Louvered shutter 4 Key punched 7 Torch cut 10 Other (specify)			
SCREEN-PERFORATED INTERVALS: From 41 ft. to 66 ft. From ft. to ft.		GRAVEL PACK INTERVALS: From 20 ft. to 66 ft. From ft. to ft.			
6 GROUT MATERIAL: 1 Neat cement 2 Cement grout 3 Bentonite 4 Other		Grout Intervals: From 0 ft. to 20 ft. From ft. to ft. From ft. to ft.			
What is the nearest source of possible contamination:		10 Livestock pens 14 Abandoned water well			
1 Septic tank 4 Lateral lines 7 Pit privy 11 Fuel storage 15 Oil well/Gas well		2 Sewer lines 5 Cess pool 8 Sewage lagoon 12 Fertilizer storage 16 Other (specify below)			
3 Watertight sewer lines 6 Seepage pit 9 Feedyard 13 Insecticide storage In field		Direction from well? How many feet?			
FROM	TO	LITHOLOGIC LOG	FROM	TO	PLUGGING INTERVALS
0	15	Clay			
15	30	Sandy clay			
30	66	Sand and gravel			
7 CONTRACTOR'S OR LANDOWNER'S CERTIFICATION: This water well was (1) constructed, (2) reconstructed, or (3) plugged under my jurisdiction and was completed on (mo/day/year) 3/23/92 and this record is true to the best of my knowledge and belief. Kansas Water Well Contractor's License No. 186 This Water Well Record was completed on (mo/day/yr) 4/28/92 under the business name of Kelly's Water Well Service by (signature) Kelly's Water Well Service					
INSTRUCTIONS: Use typewriter or ball point pen. PLEASE PRESS FIRMLY and PRINT clearly. Please fill in blanks, underline or circle the correct answers. Send top three copies to Kansas Department of Health and Environment, Bureau of Water, Topeka, Kansas 66620-0001. Telephone: 913-296-5545. Send one to WATER WELL OWNER and retain one for your records.					

OFFICE USE ONLY

T

R

EW

SEC.

1/4

1/4

1/4