

WATER WELL PLUGGING RECORD

Form WWC-5P

KSA 82a-1212

ID NO.

16335

1 LOCATION OF WATER WELL:

County: Pawnee

Fraction

1/4 NW 1/4 SE 1/4 NW 1/4

Section Number

35

Township Number

T 23 S

Range Number

16

☐ E☒ W

Street/Rural Address of Well Location; if unknown, distance & direction from nearest town or intersection: If at owner's address, check here ☐

Approximately 3.5 miles north and 4.5 miles west of Macksville.

Global Positioning Systems (GPS) information:

Latitude: 38.010725 (in decimal degrees)

Longitude: -99.054078 (in decimal degrees)

Elevation: unknown

Datum: ☐ WGS84, ☒ NAD83, ☐ NAD27

Collection Method:

☒ GPS unit (Make/Model: WAAS☐ Digital Map/Photo, ☐ Topographic Map, ☐ Land SurveyEst. Accuracy: ☐ < 3 m, ☒ 3-5 m, ☐ 5-15 m, ☐ > 15 m

2 WATER WELL OWNER:

Joe R. Baird


RR#, St. Address, Box #:

9 Roth Ct.

City, State ZIP Code:

Metamora, IL 61548

3 MARK WELL'S LOCATION WITH AN "X" IN SECTION BOX:

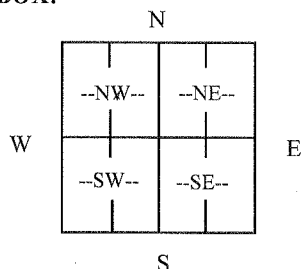

4 DEPTH OF WELL 81.80 ft.

WELL'S STATIC WATER LEVEL 37 ft

WELL WAS USED AS:

☐ Domestic☐ Public Water Supply☐ Dewatering☒ Irrigation☐ Oil Field Water Supply☐ Monitoring☐ Feedlot☐ Domestic (Lawn & Garden)☐ Injection Well☐ Industrial☐ Air Conditioning☐ Other _____Was a chemical/bacteriological sample submitted to Department? Yes ☐ No ☒

5 TYPE OF BLANK CASING USED:

☒ Steel☐ RMP (SR)☐ Wrought☐ Fiberglass☐ Other (Specify below) _____☐ PVC☐ ABS☐ Asbestos-Cement☐ Concrete TileBlank casing diameter 16 in. Was casing pulled? Yes ☐ No ☒ If yes, how much _____

Casing height above or below land surface. 48 in.

6 GROUT PLUG MATERIAL:

☐ Neat cement☐ Cement grout☒ Bentonite☐ Other _____

Grout Plug Intervals: From _____ ft. to _____ ft., From 4 ft. to 35 ft., From _____ to _____ ft.

What is the nearest source of possible contamination:

☐ Septic tank☐ Seepage pit☐ Fuel Storage☒ Other (specify below)☐ Sewer lines☐ Pit privy☐ Fertilizer storage

None Known

☐ Watertight sewer lines☐ Sewage lagoon☐ Insecticide storage☐ Lateral lines☐ Feedyard☐ Abandoned water well

Direction from well? _____

☐ Cess pool☐ Livestock pens☐ Oil well/Gas well

How many feet? _____

FROM	TO	PLUGGING MATERIALS	FROM	TO	PLUGGING MATERIALS
0	4	Topsoil			
4	35	Bentonite Chips			
35	81.80	Chlorinated Sand & Gravel			

7 CONTRACTOR'S OR LANDOWNER'S CERTIFICATION: This water well was plugged under my jurisdiction and was completed on (mo/day/year) 02/02/12 and this record is true to the best of my knowledge and belief. Kansas Water Well Contractor's License No. 185. This Water Well Record was completed on (mo/day/year) 02/07/12 under the business name of Clarke Well & Equipment, Inc. by (signature) [Signature]

INSTRUCTIONS: Use typewriter or ballpoint pen. Please press firmly and print clearly. Please fill in blanks, underline or circle the correct answers. Send top three copies to Kansas Department of Health and Environment, Bureau of Water, Geology Section, 1000 SW Jackson St., Ste. 420, Topeka, Kansas 66612-1367. Telephone: 785/296-5524. Send one to Water Well Owner and retain one for your records. Visit us at <http://www.kdheks.gov/waterwell/index.html>.

Check one:

☒ White Copy☐ Blue Copy☐ Pink Copy