

WATER WELL RECORD Form WWC-5

Division of Water Resources App. No.


34,281

Well ID

Original Record Correction Change in Well Use

1 LOCATION OF WATER WELL: County: Pawnee Fraction 1/4 1/4 NC 1/4 NW 1/4 Section Number 31 Township Number T 23 S Range Number R 16 E W

2 WELL OWNER: Last Name: Wood First: Clayton Street or Rural Address where well is located: 3 South, 2 West of Zook

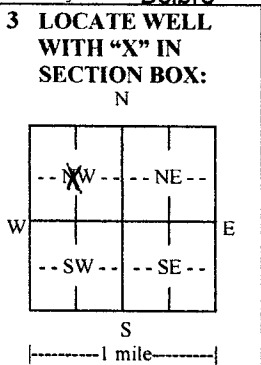

4 DEPTH OF COMPLETED WELL: 100 ft. Depth(s) Groundwater Encountered: 1) ... 2) ... 3) ... 4) Dry Well WELL'S STATIC WATER LEVEL: 32 ft.

5 Latitude: ... (decimal degrees) Longitude: ... (decimal degrees) Horizontal Datum: WGS 84 NAD 83 NAD 27

7 WELL WATER TO BE USED AS: 1. Domestic: Household, Lawn & Garden, Livestock, Irrigation, Feedlot, Industrial 5. Public Water Supply, Dewatering, Aquifer Recharge, Monitoring, Environmental Remediation

Was a chemical/bacteriological sample submitted to KDHE? Yes No Water well disinfected? Yes No

8 TYPE OF CASING USED: Steel PVC Other CASING JOINTS: Glued Clamped Welded Threaded Casing diameter 16 in. to 100 ft.

TYPE OF SCREEN OR PERFORATION MATERIAL: Steel Stainless Steel Fiberglass PVC Brass Galvanized Steel Concrete tile None used SCREEN OR PERFORATION OPENINGS ARE: Continuous Slot Mill Slot Gauze Wrapped Torch Cut Drilled Holes

9 GROUT MATERIAL: Neat cement Cement grout Bentonite Other Grout Intervals: From 20 ft. to 0 ft.

Nearest source of possible contamination: Septic Tank Lateral Lines Pit Privy Livestock Pens Insecticide Storage Sewer Lines Cess Pool Sewage Lagoon Fuel Storage Abandoned Water Well

Table with columns: 10 FROM, TO, LITHOLOGIC LOG, FROM, TO, LITHO. LOG (cont.) or PLUGGING INTERVALS. Rows include Top soil, Sandy tan clay, Small gravel w/ clay streaks, Gravel- med clean, Tan clay, Broken rock & small gravel, Brown clay & caliche.

11 CONTRACTOR'S OR LANDOWNER'S CERTIFICATION: This water well was constructed, reconstructed, or plugged under my jurisdiction and was completed on (mo-day-year) 3-26-19

Mail 1 white copy along with a fee of \$5.00 for each constructed well to: Kansas Department of Health and Environment, Bureau of Water, GWTS Section, 1000 SW Jackson St., Suite 420, Topeka, Kansas 66612-1367.