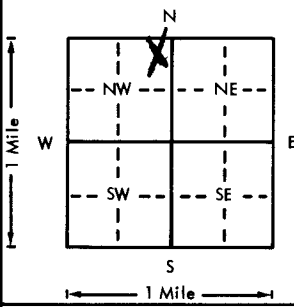


USE TYPEWRITER OR BALL
POINT PEN-PRESS FIRMLY,
PRINT CLEARLY.

WATER WELL RECORD
KSA 82a-1201-1215

Kansas Department of Health and
Environment-Division of Environment
(Water well Contractors)
Topeka, Kansas 66620

1. Location of well:		County Pawnee	Fraction ne 1/4 ne 1/4 nw 1/4	Section number 16	Township number T 23 S R 17 E/W
2. Distance and direction from nearest town or city: 8 south 1/2 west of Larned, Ks. Street address of well location if in city:			3. Owner of well: Gordon Schartz R.R. or street: 1220 Bdwy City, state, zip code: Larned, Ks. 67550		
4. Locate with "X" in section below: 			Sketch map:		
5. Type and color of material			From	To	6. Bore hole dia. 9 in. Completion date 2-28-77 Well depth 62 ft.
Top soil			0	5	7. Cable tool <input checked="" type="checkbox"/> Rotary <input type="checkbox"/> Driven <input type="checkbox"/> Dug <input type="checkbox"/> Hollow rod <input type="checkbox"/> Jetted <input type="checkbox"/> Bored <input type="checkbox"/> Reverse rotary
Brown clay			5	20	8. Use: <input checked="" type="checkbox"/> Domestic <input type="checkbox"/> Public supply <input type="checkbox"/> Industry <input type="checkbox"/> Irrigation <input type="checkbox"/> Air conditioning <input type="checkbox"/> Stock <input type="checkbox"/> Lawn <input type="checkbox"/> Oil field water <input type="checkbox"/> Other
Fine sand			20	43	9. Casing: Material pvc Weight: Above or below Threaded <input type="checkbox"/> Welded <input checked="" type="checkbox"/> Surface 18 in. RMP <input type="checkbox"/> PVC <input type="checkbox"/> Weight 160 lbs./ft. Dia. 4 in. to 62 ft. depth Wall Thickness: inches or Dia. <input type="checkbox"/> in. to <input type="checkbox"/> ft. depth gage No. 173
Yellow brown clay			43	50	10. Screen: Manufacturer's name R & B Peerless Type pvc Dia. 4 Slot/gauze 1/16 Length 10 Set between 52 ft. and 62 ft. ft. and <input type="checkbox"/> ft. and <input type="checkbox"/> ft. Gravel pack? <input checked="" type="checkbox"/> Size range of material 3/4-3/8
Sand and gravel			50	62	11. Static water level: 26 ft. below land surface Date 2-28-77 mo./day/yr.
Brown clay			62		12. Pumping level below land surfaces: ft. after hrs. pumping NA g.p.m. ft. after hrs. pumping g.p.m. Estimated maximum yield g.p.m.
					13. Water sample submitted: <input checked="" type="checkbox"/> Yes <input type="checkbox"/> No Date 2-28-77 mo./day/yr.
					14. Well head completion: <input type="checkbox"/> Pitless adapter <input type="checkbox"/> Inches above grade
					15. Well grouted? <input type="checkbox"/> With: <input type="checkbox"/> Neat cement <input type="checkbox"/> Bentonite <input checked="" type="checkbox"/> Concrete Depth: From 0 ft. to 10 ft.
					16. Nearest source of possible contamination: ft. 300 Direction east Type irrigation Well disinfected upon completion? <input checked="" type="checkbox"/> Yes <input type="checkbox"/> No
					17. Pump: <input checked="" type="checkbox"/> Not installed Manufacturer's name Model number HP Volts Length of drop pipe ft. capacity g.p.m. Type: <input type="checkbox"/> Submersible <input type="checkbox"/> Turbine <input type="checkbox"/> Jet <input type="checkbox"/> Reciprocating <input type="checkbox"/> Centrifugal <input type="checkbox"/> Other
					20. Water well contractor's certification: This well was drilled under my jurisdiction and this report is true to the best of my knowledge and belief. Rosenorantz-Bemis 134 Business name License No. Address Great Bend, Ks. Signed Fredia Aderson Date 3/9/77 Authorized representative
18. Elevation:		19. Remarks:			
Topography: <input type="checkbox"/> Hill <input type="checkbox"/> Slope <input checked="" type="checkbox"/> Upland <input type="checkbox"/> Valley					

Forward the white, blue and pink copies to the Department of Health and Environment

Form WWC-5