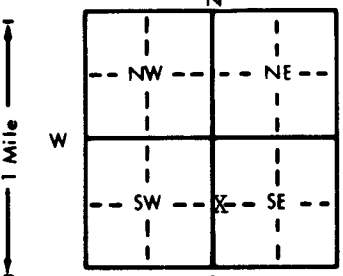
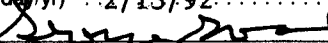


1 LOCATION OF WATER WELL:		Fraction	Section Number	Township Number	Range Number
County: Pawnee		W $\frac{1}{2}$ $\frac{1}{4}$ W $\frac{1}{2}$ $\frac{1}{4}$ SE $\frac{1}{4}$	22	T 23 S	R 17W EW
Distance and direction from nearest town or city street address of well if located within city? 2 S, 4 $\frac{1}{2}$ W of Zook, Ks.					
2 WATER WELL OWNER:		Harold Stude Sterling Drilling Co.		Stude 1-22	
RR#, St. Address, Box # :		Garfield, Ks. Box 129		Board of Agriculture, Division of Water Resources	
City, State, ZIP Code :		67529 Sterling, Ks. 67579		Application Number:	
3 LOCATE WELL'S LOCATION WITH AN "X" IN SECTION BOX:		4 DEPTH OF COMPLETED WELL: 85 ft. ELEVATION:			
		Depth(s) Groundwater Encountered 1. ft. 2. ft. 3. ft. WELL'S STATIC WATER LEVEL 25 ft. below land surface measured on mo/day/yr 12/9/91 Pump test data: Well water was ft. after hours pumping gpm Est. Yield gpm: Well water was ft. after hours pumping gpm Bore Hole Diameter in. to ft., and in. to ft. WELL WATER TO BE USED AS: 5 Public water supply 8 Air conditioning 11 Injection well 1 Domestic use 3 Feedlot 6 Oil field water supply 9 Dewatering 12 Other (Specify below) 2 Irrigation 4 Industrial 7 Lawn and garden only 10 Monitoring well Was a chemical/bacteriological sample submitted to Department? Yes.....No.....; If yes, mo/day/yr sample was submitted Water Well Disinfected? Yes No			
5 TYPE OF BLANK CASING USED:		5 Wrought iron 8 Concrete tile		CASING JOINTS: Glued Clamped	
1 Steel 3 RMP (SR)		6 Asbestos-Cement 9 Other (specify below)		Welded	
2 PVC 4 ABS		7 Fiberglass		Threaded	
Blank casing diameter 5 in. to ft., Dia in. to ft., Dia in. to ft.		Casing height above land surface 3 ft. below in., weight lbs./ft. Wall thickness or gauge No.			
TYPE OF SCREEN OR PERFORATION MATERIAL:		7 PVC 10 Asbestos-cement		11 Other (specify)	
1 Steel 3 Stainless steel 5 Fiberglass 8 RMP (SR)		12 None used (open hole)			
2 Brass 4 Galvanized steel 6 Concrete tile 9 ABS					
SCREEN OR PERFORATION OPENINGS ARE:		5 Gauzed wrapped 8 Saw cut 11 None (open hole)			
1 Continuous slot 3 Mill slot 6 Wire wrapped 9 Drilled holes					
2 Louvered shutter 4 Key punched 7 Torch cut 10 Other (specify)					
SCREEN-PERFORATED INTERVALS:		From ft. to ft., From ft. to ft.			
GRAVEL PACK INTERVALS:		From ft. to ft., From ft. to ft.			
6 GROUT MATERIAL:		1 Neat cement 2 Cement grout 3 Bentonite 4 Other			
Grout Intervals: From 6 ft. to 3 ft., From ft. to ft., From ft. to ft.					
What is the nearest source of possible contamination:		10 Livestock pens 14 Abandoned water well			
1 Septic tank 4 Lateral lines 7 Pit privy 11 Fuel storage 15 Oil well/Gas well					
2 Sewer lines 5 Cess pool 8 Sewage lagoon 12 Fertilizer storage 16 Other (specify below)					
3 Watertight sewer lines 6 Seepage pit 9 Feedyard 13 Insecticide storage					
Direction from well? South		How many feet? 60			
FROM	TO	LITHOLOGIC LOG	FROM	TO	PLUGGING INTERVALS
			85	25	Sand and gravel
			25	6	Clay
			6	3	Bentonite
			3	0	Top soil
7 CONTRACTOR'S OR LANDOWNER'S CERTIFICATION: This water well was (1) constructed, (2) reconstructed, or (3) plugged under my jurisdiction and was completed on (mo/day/year) 12/9/91 and this record is true to the best of my knowledge and belief. Kansas Water Well Contractor's License No. 186 This Water Well Record was completed on (mo/day/yr) 2/13/92 under the business name of Kelly's Water Well Service by (signature) 					
INSTRUCTIONS: Use typewriter or ball point pen. PLEASE PRESS FIRMLY and PRINT clearly. Please fill in blanks, underline or circle the correct answers. Send top three copies to Kansas Department of Health and Environment, Bureau of Water, Topeka, Kansas 66620-0001. Telephone: 913-296-5545. Send one to WATER WELL OWNER and retain one for your records.					

OFFICE USE ONLY

T

R

EW

SEC.

1/4

1/4

1/4