USE TYPEWRITER OR BALL POINT PEN-PRESS FIRMLY, PRINT CLEARLY.

T R EW sec 1/4 1/4 1/4 No.

WATER WELL RECORD
KSA 82a-1201-1215

Kansas State Dept. Of Health
(Water Well Contractors)
Forbes-Bldg. 740
Topeka, Kansas 66620

1 Location of well:	County	Township name	Fraction	Section number	Town number	Range number
	Pawnee		SESESW	36	23S	17W

Distance and direction from nearest town or city: 6½ NW

Street address of well location if in city: Belpre, Kan

3 Owner of well: LeRoy Schartz

Address: Belpre, Kans

Locate with "X" in section below:

Sketch map:

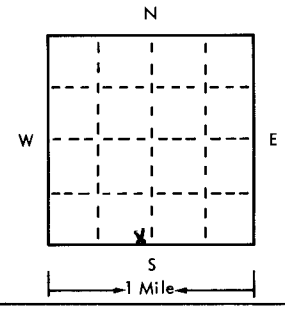

4 Well depth: 58 ft. Date of completion 2-26-75
Well diameter 8 in.

5 ☐ Cable tool ☒ Rotary ☐ Driven ☐ Dug
☐ Hollow rod ☐ Jetted ☐ Bored ☐ Reverse rotary

6 Use: ☐ Domestic ☐ Public supply ☐ Industry
☐ Irrigation ☐ Air conditioning ☐ Commercial
☐ Test well ☒ Live Stock

7 Casing: Material PVC Height: above/below
Threaded ☐ Welded ☐ Surface 12 in.
Diam. Weight ___ lbs./ft.
5 in. to 58 ft. depth Drive shoe? ☐ Yes ☒ No
___ in. to ___ ft. depth

2

Type and color of material	From	To
Top Soil - Clay	0	30
Sand - Gravel	30	58

8 Screen:
Manufacturer MPI
Type drilled Dia. 5
Slat/gauze 1/8" Length 20'
Set between 38 ft. and 58 ft.
Fittings:
Gravel pack ☒ Yes ☐ No Size range of material 1/8 - 3/4"

9 Static water level:
18 ft. below land surface Date 2-26-75

10 Pumping level below land surfaces:
___ ft. after ___ hrs. pumping ___ g.p.m.
___ ft. after ___ hrs. pumping ___ g.p.m.
Estimated maximum yield 75 g.p.m.

11 Water sample submitted:
☐ Yes ☒ No Date ___

12 Well head completion:
☐ Pitless adapter ☒ Inches above grade 12

13 Well grouted? ☒ Yes ☐ No
☒ Neat cement ☐ Bentonite ☐
Depth: From 0 ft. to 10 ft.

14 Nearest source of possible contamination: None
ft. ___ Direction ___ Type ___
Well disinfected upon completion? ☒ Yes ☐ No

15 Pump: ☒ Not installed
Manufacturer's name ___
Model number ___ HP ___ Volts ___
Length of drop pipe ___ ft. capacity ___ g.m.p.
Type:
☐ Submersible ☐ Turbine
☐ Jet ☐ Reciprocating
☐ Certrifugal ☐ Other

(use a second sheet if needed)

16 Remarks: elevation

Topography:
☐ Hill
☒ Slope
☐ Upland
☐ Valley

17 Water well contractor's certification:
This well was drilled under my jurisdiction and this report is true to the best of my knowledge and belief.
Business name Kellys Water Well Ser License No. 186
Address R 2 Great Bend KS
Signed Kelly Price Date 2-27-75
Authorized representative

Forward the white, blue and pink copies to the Kansas State Dept. Of Health.

Form WWC-5

677-H