


1 LOCATION OF WATER WELL:		Fraction			Section Number		Township Number			Range Number				
County:	Pawnee	SW	¼	NW	¼	SE	¼	1	T	23	S	R	18W	E/W

Distance and direction from nearest town or city street address of well if located within city?

In Garfield, Kansas

2] WATER WELL OWNER:	Dana Bunting	
RR#, St. Address, Box # :	116 Wichita St.	Board of Agriculture, Division of Water Resources
City, State, ZIP Code :	Kinsley, Kansas 67547	Application Number:

3	LOCATE WELL'S LOCATION WITH AN "X" IN SECTION BOX:	4	DEPTH OF COMPLETED WELL..... 71	ft.	ELEVATION:..... Unknown
---	--	---	---------------------------------	-----	-------------------------

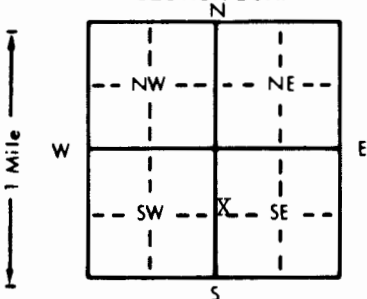

4) DEPTH OF COMPLETED WELL.....71..... ft. ELEVATION:.....Unknown.....

Depth(s) Groundwater Encountered 1. 28..... ft. 2. ft. 3. ft.

WELL'S STATIC WATER LEVEL28 ft. below land surface measured on mo/day/yr 12/1/95

Pump test data: Well water was ft. after hours pumping gpm

Est. Yield 40..... gpm: Well water was ft. after hours pumping gpm

Bore Hole Diameter 7. 7/8..... in. to 71..... ft., and..... in. to ft.

WELL WATER TO BE USED AS:

1 Domestic	3 Feedlot	6 Oil field water supply	9 Dewatering	12 Other (Specify below)
2 Irrigation	4 Industrial	7 Lawn and garden only	10 Monitoring well	

Was a chemical/bacteriological sample submitted to Department? Yes.....No.....; If yes, mo/day/yr sample was submitted.....

Water Well Disinfected? Yes.....No.....

5	TYPE OF BLANK CASING USED:		5 Wrought iron	8 Concrete tile	CASING JOINTS: Glued Clamped Welded Threaded
	1 Steel	3 RMP (SR)	6 Asbestos-Cement	9 Other (specify below)	
	2 PVC	4 ABS	7 Fiberglass		

Blank casing diameter 5 in. to 61 ft., Dia in. to ft., Dia in. to ft.
Casing height above land surface 12 in., weight 2.8 lbs./ft. Wall thickness or gauge No. Sch. 40

TYPE OF SCREEN OR PERFORATION MATERIAL:			7 <u>PVC</u>	10 Asbestos-cement
1 Steel	3 Stainless steel	5 Fiberglass	8 <u>RMP (SR)</u>	11 Other (specify)
2 Brass	4 Galvanized steel	6 Concrete tile	9 ABS	12 None used (open hole)

SCREEN OR PERFORATION OPENINGS ARE:

1 Continuous slot	3 Mill slot	5 Gauzed wrapped	8 Saw cut	11 None (open hole)
2 Louvered shutter	4 Key punched	6 Wire wrapped	9 Drilled holes	
		7 Torch cut	10 Other (specify)	

SCREEN-PERFORATED INTERVALS: From 61 ft. to 71 ft., From ft. to ft.
From ft. to ft., From ft. to ft.
GRAVEL PACK INTERVALS: From 20 ft. to 71 ft., From ft. to ft.
From ft. to ft., From ft. to ft.

6 GROUT MATERIAL: 1 Neat cement 2 Cement grout 3 Bentonite 4 Other

Grout Intervals: From 0 ft. to 20 ft. From ft. to ft. From ft. to ft.

What is the nearest source of possible contamination:

1 Septic tank	4 Lateral lines	7 Pit privy	10 Livestock pens	14 Abandoned water well
2 Sewer lines	5 Cess pool	8 Sewage lagoon	11 Fuel storage	15 Oil well/Gas well
3 Watertight sewer lines	6 Seepage pit	9 Feedyard	12 Fertilizer storage	16 Other (specify below)
			13 Insecticide storage	

Direction from well? West How many feet? 20

[illegible]

7. CONTRACTOR'S OR LANDOWNER'S CERTIFICATION: This water well was (1) constructed, (2) reconstructed, or (3) plugged under my jurisdiction and was completed on (mo/day/year) 12/1/95 and this record is true to the best of my knowledge and belief. Kansas Water Well Contractor's License No. 186... This Water Well Record was completed on (mo/day/yr) 12/4/95 under the business name of Kelly's Water Well Service, Inc. by (signature) *Sharon Good*