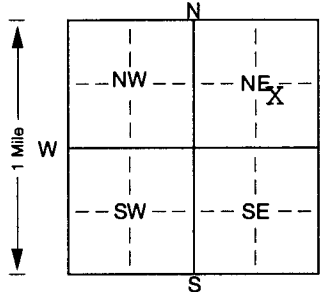


1 LOCATION OF WATER WELL:		Fraction	Section Number	Township Number	Range Number
County: Pawnee		NW 1/4 SE 1/4 NE 1/4	24	T 23 S	R 18w EW
Distance and direction from nearest town or city street address of well if located within city?					
2 1/2S of Garfield, Ks.					
2 WATER WELL OWNER: Tim C. Schaller					
RR#, St. Address, Box # : RR 2 Box 6A			Board of Agriculture, Division of Water Resources		
City, State, ZIP Code : Larned, KS 67550			Application Number:		
3 LOCATE WELL'S LOCATION WITH		4 DEPTH OF COMPLETED WELL. 49 ft. ELEVATION: unknown			
AN "X" IN SECTION BOX:		Depth(s) Groundwater Encountered 1. 22 ft. 2. ft. 3. ft.			
		WELL'S STATIC WATER LEVEL 22 ft. below land surface measured on mo/day/yr 05/30/03			
		Pump test data: Well water was ft. after hours pumping gpm			
		Est. Yield 15 gpm: Well water was ft. after hours pumping gpm			
		Bore Hole Diameter. 8 in. to 49 ft., and in. to ft.			
		WELL WATER TO BE USED AS: 5 Public water supply 8 Air conditioning 11 Injection well			
		1 Domestic 3 Feedlot 6 Oil field water supply 9 Dewatering 12 Other (Specify below)			
		2 Irrigation 4 Industrial 7 Domestic (lawn & garden) 10 Monitoring well			
		Was a chemical/bacteriological sample submitted to Department? Yes. No. ; If yes, mo/day/yr sample was submitted			
		Water Well Disinfected? Yes No			
5 TYPE OF BLANK CASING USED:					
1 Steel		3 RMP (SR)		5 Wrought iron	
2 PVC		4 ABS		6 Asbestos-Cement	
				7 Fiberglass	
Blank casing diameter 5 in. to 29 ft., Dia in. to ft., Dia in. to ft.					
Casing height above land surface. 12 in., weight 2.8 lbs./ft. Wall thickness or gauge No. Sch. 40					
TYPE OF SCREEN OR PERFORATION MATERIAL:					
1 Steel		3 Stainless steel		5 Fiberglass	
2 Brass		4 Galvanized steel		6 Concrete tile	
				7 PVC	
				8 RMP (SR)	
				9 ABS	
				10 Asbestos-cement	
				11 Other (specify)	
				12 None used (open hole)	
SCREEN OR PERFORATION OPENINGS ARE:					
1 Continuous slot		3 Mill slot		5 Gauzed wrapped	
2 Louvered shutter		4 Key punched		6 Wire wrapped	
				7 Torch cut	
				8 Saw cut	
				9 Drilled holes	
				10 Other (specify) ft.	
				11 None (open hole)	
SCREEN-PERFORATED INTERVALS: From 29 ft. to 49 ft., From ft. to ft.					
GRAVEL PACK INTERVALS: From 20 ft. to 49 ft., From ft. to ft.					
6 GROUT MATERIAL: 1 Neat cement 2 Cement grout 3 Bentonite 4 Other					
Grout Intervals: From 0 ft. to 20 ft., From ft. to ft., From ft. to ft.					
What is the nearest source of possible contamination:					
1 Septic tank		4 Lateral lines		7 Pit privy	
2 Sewer lines		5 Cess pool		8 Sewage lagoon	
3 Watertight sewer lines		6 Seepage pit		9 Feedyard	
				10 Livestock pens	
				11 Fuel storage	
				12 Fertilizer storage	
				13 Insecticide storage	
				14 Abandoned water well	
				15 Oil well/Gas well	
				16 Other (specify below)	
				none - in pasture	
Direction from well? How many feet?					
FROM TO LITHOLOGIC LOG FROM TO PLUGGING INTERVALS					
0 10 top sand					
10 25 clay					
25 46 sand and gravel					
46 49 shale					
7 CONTRACTOR'S OR LANDOWNER'S CERTIFICATION: This water well was (1) constructed, (2) reconstructed, or (3) plugged under my jurisdiction and was completed on (mo/day/year) 05/30/03 and this record is true to the best of my knowledge and belief. Kansas					
Water Well Contractor's Licence No. 186 This Water Well Record was completed on (mo/day/yr) 06/02/03					
under the business name of Kelly's Water Well Service, Inc. by (signature) Kathryn L. Good					
INSTRUCTIONS: Use typewriter or ball point pen. PLEASE PRESS FIRMLY and PRINT clearly. Please fill in blanks, underline or circle the correct answers. Send top three copies to Kansas Department of Health and Environment, Bureau of Water, Topeka, Kansas 66620-0001. Telephone 785-296-5524. Send one to WATER WELL OWNER and retain one for your records. Fee of \$5.00 for each constructed well.					