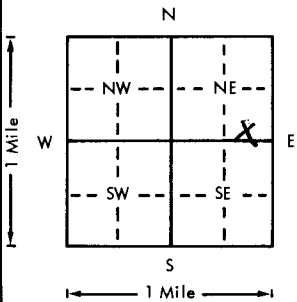


USE TYPEWRITER OR BALL  
POINT PEN-PRESS FIRMLY,  
PRINT CLEARLY.

WATER WELL RECORD  
KSA 82a-1201-1215

Kansas Department of Health and  
Environment-Division of Environment  
(Water well Contractors)  
Topeka, Kansas 66620

1. Location of well:		County <u>Pawnee</u>	Fraction <u>SE NE</u> <u>SE 1/4 NE 1/4 NE 1/4</u>	Section number <u>34</u>	Township number <u>23</u> S	Range number <u>18</u> E/W
2. Distance and direction from nearest town or city: <u>4 1/2 mi NW of Linn, Kas.</u> Street address of well location if in city:				3. Owner of well: <u>Robert Greene</u> R.R. or street: City, state, zip code: <u>GARFIELD, KS.</u>		
4. Locate with "X" in section below:		Sketch map:		6. Bore hole dia. <u>29</u> in. Completion date <u>4-23-76</u> Well depth <u>64</u> ft.		
				7. <input type="checkbox"/> Cable tool <input checked="" type="checkbox"/> Rotary <input type="checkbox"/> Driven <input type="checkbox"/> Dug <input type="checkbox"/> Hollow rod <input type="checkbox"/> Jetted <input type="checkbox"/> Bored <input type="checkbox"/> Reverse rotary		
5. Type and color of material				From	To	8. Use: <input type="checkbox"/> Domestic <input type="checkbox"/> Public supply <input type="checkbox"/> Industry <input checked="" type="checkbox"/> Irrigation <input type="checkbox"/> Air conditioning <input type="checkbox"/> Stock <input type="checkbox"/> Lawn <input type="checkbox"/> Oil field water <input type="checkbox"/> Other
<u>Sandy Top Soil</u>				<u>0</u>	<u>3</u>	9. Casing: Material <u>Steel</u> Height: <u>Above</u> or below Threaded <input type="checkbox"/> Welded <input checked="" type="checkbox"/> Surface <u>18</u> in. RMP <input type="checkbox"/> PVC <input type="checkbox"/> Weight <u>      </u> lbs./ft. Dia. <u>16</u> in. to <u>64</u> ft. depth Wall Thickness: <u>      </u> inches or Dia. <u>      </u> in. to <u>      </u> ft. depth Gauge No. <u>      </u>
<u>Sandy Brown Clay</u>				<u>3</u>	<u>17</u>	10. Screen: Manufacturer's name <u>Duerr</u> Type <u>Steel</u> Dia. <u>16</u> Slot gauge <u>3/16</u> Length <u>20</u> Set between <u>44</u> ft. and <u>64</u> ft. Gravel pack? <input checked="" type="checkbox"/> Size range of material <u>1/2 3/4 1 1/2</u>
<u>Brown &amp; Gray Clay</u>				<u>17</u>	<u>25</u>	11. Static water level: <u>      </u> mo./day/yr. <u>17</u> ft. below land surface Date <u>2-3-76</u>
<u>Sand &amp; Gravel Clean, coarse, loose</u>				<u>25</u>	<u>64</u>	12. Pumping level below land surfaces: <u>16</u> ft. after <u>1</u> hrs. pumping <u>1000</u> g.p.m. <u>      </u> ft. after <u>      </u> hrs. pumping <u>      </u> g.p.m. Estimated maximum yield <u>1100</u> g.p.m.
<u>Sand Rock</u>				<u>64</u>	<u>65</u>	13. Water sample submitted: <u>      </u> mo./day/yr. <input checked="" type="checkbox"/> Yes <input type="checkbox"/> No Date <u>2-6-76</u>
						14. Well head completion: <input type="checkbox"/> Pitless adapter <u>      </u> Inches above grade
						15. Well grouted? <input checked="" type="checkbox"/> With: <input type="checkbox"/> Neat cement <input type="checkbox"/> Bentonite <input checked="" type="checkbox"/> Concrete Depth: From <u>0</u> ft. to <u>10</u> ft.
						16. Nearest source of possible contamination: ft. <u>340</u> Direction <u>South</u> Type <u>Septic</u> Well disinfected upon completion? <input type="checkbox"/> Yes <input type="checkbox"/> No
						17. Pump: <input type="checkbox"/> Not installed Manufacturer's name <u>WLR</u> Model number <u>2-M3-12</u> HP <u>80</u> Volts <u>      </u> Length of drop pipe <u>60</u> ft. capacity <u>800</u> g.p.m. Type: <input type="checkbox"/> Submersible <input checked="" type="checkbox"/> Turbine <input type="checkbox"/> Jet <input type="checkbox"/> Reciprocating <input type="checkbox"/> Centrifugal <input type="checkbox"/> Other
(Use a second sheet if needed)						
18. Elevation:		19. Remarks:		20. Water well contractor's certification: This well was drilled under my jurisdiction and this report is true to the best of my knowledge and belief. <u>Rosenkrantz-Bernis</u> <u>134</u> Business name <u>Great Bend, KS.</u> License No. <u>      </u> Address <u>      </u> Signed <u>Freddie Hudson</u> Date <u>9/29/76</u> Authorized representative		
Topography: <input type="checkbox"/> Hill <input type="checkbox"/> Slope <input checked="" type="checkbox"/> Upland <input type="checkbox"/> Valley						

Forward the white, blue and pink copies to the Department of Health and Environment

Form WWC-5