


1 LOCATION OF WATER WELL: County: Pawnee Fraction: SW 1/4 SE 1/4 SE 1/4 Section Number: 1 Township Number: T 23 S Range Number: R 17 E
 Distance and direction from nearest town or city street address of well if located within city? 18

2 WATER WELL OWNER: Pawnee County Coop
 RR#, St. Address, Box #: Highway 56
 City, State, ZIP Code: Garfield, Kansas
 Board of Agriculture, Division of Water Resource
 Application Number:

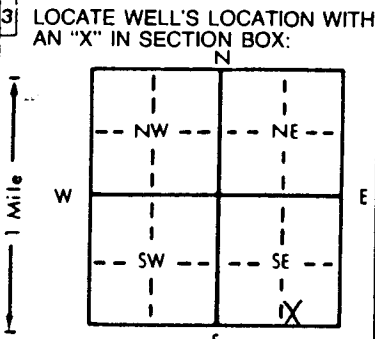

4 DEPTH OF COMPLETED WELL: 19 ft. ELEVATION: 15 ft.
 Depth(s) Groundwater Encountered 1. 15 ft. 2. 15 ft. 3. 15 ft.
 WELL'S STATIC WATER LEVEL 14.29 ft. below TOC measured on mo/day/yr
 Pump test data: Well water was 14.29 ft. after 1 hours pumping 1 gpm
 Est. Yield 7.5/8 gpm: Well water was 19 ft. after 1 hours pumping 1 gpm
 Bore Hole Diameter: 7.5/8 in. to 19 ft., and 19 in. to 19 ft.
 WELL WATER TO BE USED AS:
 5 Public water supply 8 Air conditioning 11 Injection well
 1 Domestic 3 Feedlot 6 Oil field water supply 9 Dewatering 12 Other (Specify below)
 2 Irrigation 4 Industrial 7 Lawn and garden only Monitoring well
 Was a chemical/bacteriological sample submitted to Department? Yes X No X; If yes, mo/day/yr sample was submitted
 Water Well Disinfected? Yes X No X

5 TYPE OF BLANK CASING USED:
 1 Steel 3 RMP (SR) 5 Wrought iron 8 Concrete tile CASING JOINTS: Glued X Clamped X
 PVC 4 ABS 6 Asbestos-Cement 9 Other (specify below) Welded X
 7 Fiberglass Threaded X
 Blank casing diameter 2 in. to 9 ft., Dia 2 in. to 9 ft., Dia 2 in. to 9 ft.
 Casing height above land surface 0 in., weight 0 lbs./ft. Wall thickness or gauge No. sch. 40
 TYPE OF SCREEN OR PERFORATION MATERIAL:
 1 Steel 3 Stainless steel 5 Fiberglass PVC 10 Asbestos-cement
 2 Brass 4 Galvanized steel 6 Concrete tile 8 RMP (SR) 11 Other (specify)
 9 ABS 12 None used (open hole)
 SCREEN OR PERFORATION OPENINGS ARE:
 1 Continuous slot Mill slot 5 Gauzed wrapped 8 Saw cut 11 None (open hole)
 2 Louvered shutter 4 Key punched 6 Wire wrapped 9 Drilled holes
 7 Torch cut 10 Other (specify)
 SCREEN-PERFORATED INTERVALS: From 9 ft. to 19 ft., From 9 ft. to 19 ft.
 GRAVEL PACK INTERVALS: From 7 ft. to 19 ft., From 7 ft. to 19 ft.

6 GROUT MATERIAL: 1 Neat cement Cement grout Bentonite 4 Other
 Grout Intervals: From 0 ft. to 5 ft., From 5 ft. to 5 ft., From 5 ft. to 7 ft., From 7 ft. to 7 ft.
 What is the nearest source of possible contamination:
 1 Septic tank 4 Lateral lines 7 Pit privy 10 Livestock pens 14 Abandoned water well
 2 Sewer lines 5 Cess pool 8 Sewage lagoon Fuel storage 15 Oil well/Gas well
 3 Watertight sewer lines 6 Seepage pit 9 Feedyard 12 Fertilizer storage 16 Other (specify below)
 13 Insecticide storage
 Direction from well? North How many feet? 170

FROM	TO	LITHOLOGIC LOG	FROM	TO	PLUGGING INTERVALS
0	6"	Cly, lt brn, v slty, mod snd, f-c grnd, sl grvl			
6"	4	Cly, drk brn, v slty, sl plstc, damp			
4	9	Cly, med brn, v slty, moist, sl v f-f grnd snd, mod plstc			
9	13	Snd, v f-f grnd, v slty, sl cly, moist, yell-orn clrd, well srted.			
13	16	Snd, f-c grnd, sl grvl, prly srted, yell-brn			
16	19	Snd, a.a., but mod-v grly			
					MW10 - Flushmount

7 CONTRACTOR'S OR LANDOWNER'S CERTIFICATION: This water well was constructed, reconstructed, or plugged under my jurisdiction and was completed on (mo/day/year) 08-02-94 and this record is true to the best of my knowledge and belief. Kansas Water Well Contractor's License No. 527 This Water Well Record was completed on (mo/day/yr) 09-06-94 under the business name of GeoCore Services, Inc. by (signature) Dale A. Kohl

INSTRUCTIONS: Use typewriter or ball point pen. PLEASE PRESS FIRMLY and PRINT clearly. Please fill in blanks, underline or circle the correct answers. Send top three copies to Kansas Department of Health and Environment, Bureau of Water, Topeka, Kansas 66620-0001. Telephone: 913-296-5545. Send one to WATER WELL OWNER and retain one for your records.