

CORRECTION(S) TO WATER WELL RECORD (WWC-5)
(to rectify lacking or incorrect information)

County: Edwards

Location listed as:

Location changed to:

Section-Township-Range: 23-95-19E

9-235-19W

Fraction ($\frac{1}{4}$ $\frac{1}{4}$ $\frac{1}{4}$): SW SW SW

SW SW SW

Other changes: Initial statements: _____

Changed to: _____

Comments: _____

verification method: written & legal descriptions, position on plat map,
and Kinsley & Rose/ SW 1:24,000 topo. maps.

initials: DRD date: 8/19/2003

submitted by: Kansas Geological Survey, Data Resources Library, 1930 Constant Ave., Lawrence, KS 66047-3726
to: Kansas Dept of Health & Environment, Bureau of Water, 1000 SW Jackson, Suite 420, Topeka, KS 66612-1367.

WATER WELL RECORD Form WWC-5 KSA 82a-1212


1 LOCATION OF WATER WELL: Fraction Section Number Township Number Range Number
 COUNTY: EDWARDS SW 1/4 SW 1/4 SW 1/4 23 T 9 S R 19 E

Distance and direction from nearest town or city street address of well if located within city?
 FROM KINSLEY - 8 MILES NORTH, 1 MILE WEST AND 1 MILE NORTH

2 WATER WELL OWNER: BOESE, RODNEY Board of Agriculture, Division of Water Resources
 RR#, St. Address, Box #: BOX 36 Application Number:
 City, State, ZIP code: ROZEL, KS 67574-

3 LOCATE WELL'S LOCATION WITH AN "X" IN SECTION BOX:

4 DEPTH OF COMPLETED WELL 204 ELEVATION: 0
 Depth(s) Groundwater Encountered 1. 0 ft. 2. 0 ft. 3. 0 ft.

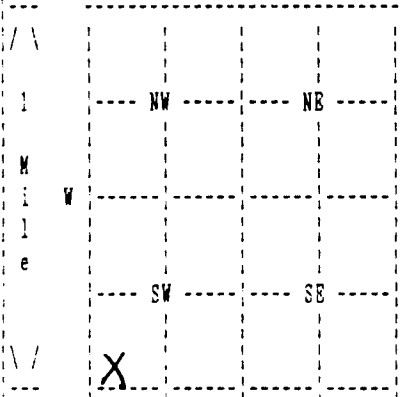

WELL'S STATIC WATER LEVEL 73 ft. below land surface measured on no/day/yr 07/01/02
 Pump testdata: Well water was 0 ft. after 0 hours pumping 0 gpm

Estimated Yield 40 gpm: Well water was 0 ft. after 0 hours pumping 0 gpm

Bore Hole Diameter 9 in. to 204 ft., and in. to 0 ft.

WELL WATER TO BE USED AS: DOMESTIC

Was a chemical/bacteriological sample submitted to department? No ;
 If yes, no/day/yr sample was submitted Water well disinfected? Yes

5 TYPE OF BLANK CASING USED: PVC CASING JOINTS: GLUED
 Blank casing diameter 5 in. to 204 ft., Dia in. to 0 ft., Dia in. to 0 ft.
 Casing height above land surface 12 in., weight 200 lbs/ft. Wall thickness or gauge No. 21
 TYPE OF SCREEN OR PERFORATION MATERIAL: PVC
 SCREEN OR PERFORATION OPENINGS ARE: SAW CUT

SCREEN PERFORATED INTERVALS: From 160 ft. to 200 ft., From 0 ft. to 0 ft.
 From 0 ft. to 0 ft., From 0 ft. to 0 ft.
 GRAVEL PACK INTERVALS: From 20 ft. to 204 ft., From 0 ft. to 0 ft.
 From 0 ft. to 0 ft., From 0 ft. to 0 ft.

6 GROUT MATERIAL BENTONITE
 Grout Intervals: From 0 ft. to 20 ft., From 0 ft. to 0 ft., From 0 ft. to 0 ft.
 What is the nearest source of possible contamination: NONE - NEW SITE
 Direction from well? How many feet? 0

| FROM | TO | LITHOLOGIC LOG | FROM | TO | PLUGGING INTERVALS |
|------|-----|---------------------------------------|------|----|--------------------|
| 0 | 20 | 01 TOPSOIL 32 TAN CLAY 16 GRAY CLAY | | | |
| 20 | 90 | 16 GRAY CLAY | | | |
| 90 | 120 | 29 SANDSTONE | | | |
| 120 | 130 | 16 GRAY CLAY 24 THINROCLAYER | | | |
| 130 | 155 | 29 SANDSTONE | | | |
| 155 | 162 | 16 GRAY CLAY 26 RED CLAY | | | |
| 162 | 176 | 29 SANDSTONE | | | |
| 176 | 188 | 16 GRAY CLAY 26 RED CLAY | | | |
| 188 | 200 | 29 SANDSTONE | | | |
| 200 | 220 | 16 GRAY CLAY 26 RED CLAY 29 SANDSTONE | | | |

7 CONTRACTOR'S OR LANDOWNER'S CERTIFICATION: This water well was Constructed under my jurisdiction and was completed on (no/day/year) 07/01/02 and this record is true to the best of my knowledge and belief. Kansas Water Well Contractor's License No. 179 This Water Well Record was completed on (no/day/yr) 07/11/02 under the business name of JOB'S WELL SERVICE, INC. by (signature) *Justin Cick*