
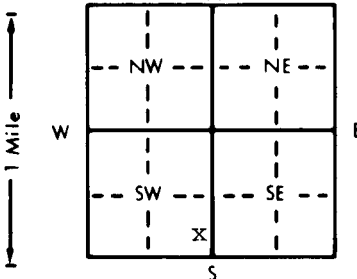


1 LOCATION OF WATER WELL: County: <u>Harvey</u>		Fraction <u>SE 1/4</u> <u>SE 1/4</u> <u>SW 1/4</u>		Section Number <u>29</u>	Township Number <u>T 23</u> <u>S</u>	Range Number <u>R 2</u> <u>NE/W</u>
Distance and direction from nearest town or city street address of well if located within city? <u>Approximately 2 1/2 miles west and 1 mile north of Halstead</u>						
2 WATER WELL OWNER: RR#, St. Address, Box # : City, State, ZIP Code :		City of Wichita <u>455 N. Main</u> <u>Wichita, KS 67202</u> Board of Agriculture, Division of Water Resources Application Number:				
3 LOCATE WELL'S LOCATION WITH AN "X" IN SECTION BOX: <div style="text-align: center;"></div>		4 DEPTH OF COMPLETED WELL: <u>160</u> ft. ELEVATION: <u>unknown</u> Depth(s) Groundwater Encountered 1. <u>1</u> ft. 2. <u>1</u> ft. 3. <u>1</u> ft. WELL'S STATIC WATER LEVEL <u>54.8</u> ft. below land surface measured on mo/day/yr <u>5-9-97</u> Pump test data: Well water was <u>not ch'd</u> ft. after <u> </u> hours pumping <u> </u> gpm Est. Yield <u>unknown</u> gpm: Well water was <u> </u> ft. after <u> </u> hours pumping <u> </u> gpm Bore Hole Diameter <u>6</u> in. to <u>175</u> ft., and <u> </u> in. to <u> </u> ft. WELL WATER TO BE USED AS: 5 Public water supply 8 Air conditioning 11 Injection well 1 Domestic 3 Feedlot 6 Oil field water supply 9 Dewatering 12 Other (Specify below) 2 Irrigation 4 Industrial 7 Lawn and garden only 10 <u>Monitoring well</u> <u>Piezometer</u> Was a chemical/bacteriological sample submitted to Department? Yes <u> </u> No <u>X</u> ; If yes, mo/day/yr sample was submitted <u> </u> Water Well Disinfected? Yes <u> </u> No <u>X</u>				
5 TYPE OF BLANK CASING USED: 1 Steel 3 RMP (SR) 2 <u>PVC</u> 4 ABS Blank casing diameter <u>2</u> in. to <u>156</u> ft., Dia. <u> </u> in. to <u> </u> ft., Dia. <u> </u> in. to <u> </u> ft. Casing height above land surface <u>24</u> in., weight <u>96</u> lbs./ft. Wall thickness or gauge No. <u>218</u> TYPE OF SCREEN OR PERFORATION MATERIAL: 1 Steel 3 Stainless steel 5 Fiberglass 7 <u>PVC</u> 10 Asbestos-cement 2 Brass 4 Galvanized steel 6 Concrete tile 8 RMP (SR) 11 Other (specify) <u> </u> 12 None used (open hole) SCREEN OR PERFORATION OPENINGS ARE: 1 Continuous slot 3 Mill slot 5 Gauzed wrapped 8 Saw cut 11 None (open hole) 2 Louvered shutter 4 Key punched 6 Wire wrapped 9 Drilled holes 7 Torch cut 10 Other (specify) <u> </u> SCREEN-PERFORATED INTERVALS: From <u>156</u> ft. to <u>166</u> ft., From <u> </u> ft. to <u> </u> ft. From <u> </u> ft. to <u> </u> ft., From <u> </u> ft. to <u> </u> ft. GRAVEL PACK INTERVALS: From <u>154</u> ft. to <u>175</u> ft., From <u> </u> ft. to <u> </u> ft. From <u> </u> ft. to <u> </u> ft., From <u> </u> ft. to <u> </u> ft.		CASING JOINTS: Glued <u>X</u> Clamped <u> </u> Welded <u> </u> Threaded <u> </u>				
6 GROUT MATERIAL: 1 Neat cement 2 Cement grout 3 Bentonite 4 Other <u>Bentonite Holeplug</u> Grout Intervals: From <u> </u> ft. to <u> </u> ft., From <u> </u> ft. to <u> </u> ft., From <u>0</u> ft. to <u>154</u> ft. What is the nearest source of possible contamination: 1 Septic tank 4 Lateral lines 7 Pit privy 10 Livestock pens 14 Abandoned water well 2 Sewer lines 5 Cess pool 8 Sewage lagoon 11 Fuel storage 15 Oil well/Gas well 3 Watertight sewer lines 6 Seepage pit 9 Feedyard 12 Fertilizer storage 16 Other (specify below) 13 Insecticide storage <u>none known</u> Direction from well? <u> </u> How many feet? <u> </u>						
FROM TO LITHOLOGIC LOG		FROM TO		PLUGGING INTERVALS		
0	4	Topsoil		174	175	Clay, white, hard
4	9	Clay, Brown, hard				
9	28	Sand and gravel, coarse, medium, fine				
28	44	Clay, black, and gray, hard				
44	54	Clay, gray, soft				
54	61	Clay, green, soft				
61	66	Sand, medium and fine				
66	83	Clay, white and brown, soft				
88	106	Sand, medium and fine				
106	118	Clay, green, hard				
118	136	Clay, white, hard				
136	144	Sand, medium and fine				
144	149	Clay, white, hard				
149	174	Sand, medium and fine				
7 CONTRACTOR'S OR LANDOWNER'S CERTIFICATION: This water well was (1) <u>constructed</u> , (2) <u>reconstructed</u> , or (3) <u>plugged</u> under my jurisdiction and was completed on (mo/day/year) <u>5-9-97</u> and this record is true to the best of my knowledge and belief. Kansas Water Well Contractor's License No. <u>185</u> This Water Well Record was completed on (mo/day/yr) <u>5-30-97</u> under the business name of <u>Clarke Well & Equipment, Inc.</u> by (signature) <u>Clarke Well & Equipment, Inc.</u>						
INSTRUCTIONS: Use typewriter or ball point pen. PLEASE PRESS FIRMLY and PRINT clearly. Please fill in blanks, underline or circle the correct answers. Send top three copies to Kansas Department of Health and Environment, Bureau of Water, Topeka, Kansas 66620-0001. Telephone: 913-296-5545. Send one to WATER WELL OWNER and retain one for your records.						

CLARKE WELL & EQUIPMENT, INC.

WELL RECORD
DESIGN & CONSTRUCTION SHEET

JOB NUMBER 3679
 WELL OWNER City of Wichita WELL NO. H9
 WELL USE Piezometer APPROPRIATION NO. _____
 LOCATION SE 1/4 SE 1/4 SW 1/4, SECTION NO. 29
 T 23 S, R 2 W/E Harvey COUNTY Kansas
90 FSL, 2952 FEL State

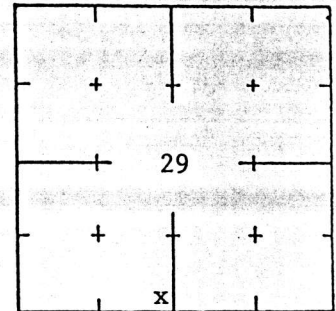

SIZE HOLE 6 "DIA.
 SIZE CASING 2 " DIA. .218 WALL; WT. .96 LBS/FT PVC MATERIAL
 SIZE SCREEN 2 " DIA. .218 WALL PVC MATERIAL .030 Mill SLOT/ HOLES

FORMATION LOG. From test no. from to			Formation Thickness	From ground level	From	To	Ftg.
0	4	Topsoil		Casing	0	156	156
4	9	Clay, brown, hard		Screen	156	166	10
9	28	Sand and gravel, coarse, medium, fine					
28	44	Clay, black and gray, hard					
44	54	Clay, gray, soft					
54	61	Clay, green, soft					
61	66	Sand, medium and fine					
66	83	Clay, green, soft					
83	88	Clay, white and brown, soft					
88	106	Sand, medium and fine					
106	118	Clay, green, hard					
118	136	Clay, white, hard					
136	144	Sand, medium and fine					
144	149	Clay, white, hard					
149	174	Sand, medium and fine		CASING LEFT ABOVE GROUND			2
174	175	Clay, white, hard		TOTAL CASING & SCREEN			160

STATIC WATER LEVEL 54.8 CHLORINATE none QUANTITY USED
 From ground level

GRAVEL PACK ANNULAR SEAL
154 TO 175 0 TO 154 Bentonite Holeplug
 TO TO

WHAT IS THE NEAREST SOURCE OF POSSIBLE CONTAMINATION None known

DIRECTION FROM WELL HOW MANY FEET

DESIGNED BY DRILLED BY Edward Cass DATE 5-9-97