


<b>1 LOCATION OF WATER WELL:</b>		<b>Fraction</b>	<b>Section Number</b>	<b>Township Number</b>	<b>Range Number</b>
County: <u>Harvey</u>		<u>SE</u> $\frac{1}{4}$ <u>SE</u> $\frac{1}{4}$ <u>SW</u> $\frac{1}{4}$	<u>29</u>	<u>T</u> <u>23</u> <u>S</u>	<u>R</u> <u>2</u> <u>E/W</u>
Distance and direction from nearest town or city street address of well if located within city? <u>Approximately 2½ miles west and 1 mile north of Halstead</u>					
<b>2 WATER WELL OWNER:</b>		<b>City of Wichita</b>			
RR#, St. Address, Box # :		<u>455 N. Main</u>		Board of Agriculture, Division of Water Resources	
City, State, ZIP Code :		<u>Wichita, KS 67202</u>		Application Number:	
<b>3 LOCATE WELL'S LOCATION WITH AN "X" IN SECTION BOX:</b>		<b>4 DEPTH OF COMPLETED WELL</b> <u>166</u> <b>ft.</b> <b>ELEVATION:</b> <u>unknown</u>			
<div style="text-align: center;"><p>1 Mile</p></div>		Depth(s) Groundwater Encountered 1. .... ft. 2. .... ft. 3. .... ft.			
		WELL'S STATIC WATER LEVEL <u>50.50</u> ft. below land surface measured on mo/day/yr <u>5-12-97</u>			
		Pump test data: Well water was <u>not ch'd</u> ft. after ..... hours pumping ..... gpm			
		Est. Yield <u>unknown</u> gpm: Well water was ..... ft. after ..... hours pumping ..... gpm			
		Bore Hole Diameter <u>6</u> in. to <u>171</u> ft. and ..... in. to ..... ft.			
WELL WATER TO BE USED AS:		5 Public water supply 8 Air conditioning 11 Injection well			
1 Domestic 3 Feedlot 6 Oil field water supply 9 Dewatering 12 Other (Specify below)		<u>Piezometer</u>			
2 Irrigation 4 Industrial 7 Lawn and garden only 10 Monitoring well					
Was a chemical/bacteriological sample submitted to Department? Yes..... No <u>X</u> ..... If yes, mo/day/yr sample was submitted					
Water Well Disinfected? Yes..... No <u>X</u> .....					
<b>5 TYPE OF BLANK CASING USED:</b>		5 Wrought iron 8 Concrete tile		CASING JOINTS: Glued <u>X</u> Clamped .....	
1 Steel 3 RMP (SR)		6 Asbestos-Cement 9 Other (specify below)		Welded .....	
2 PVC 4 ABS		7 Fiberglass		Threaded .....	
Blank casing diameter <u>2</u> in. to <u>154</u> ft. Dia ..... in. to ..... ft. Dia ..... in. to ..... ft.					
Casing height above land surface <u>24</u> in. weight <u>96</u> lbs./ft. Wall thickness or gauge No. <u>218</u>					
<b>TYPE OF SCREEN OR PERFORATION MATERIAL:</b>					
1 Steel 3 Stainless steel 5 Fiberglass 8 RMP (SR) 11 Other (specify) .....		7 PVC 10 Asbestos-cement			
2 Brass 4 Galvanized steel 6 Concrete tile 9 ABS 12 None used (open hole)					
<b>SCREEN OR PERFORATION OPENINGS ARE:</b>					
1 Continuous slot 3 Mill slot 5 Gauzed wrapped 8 Saw cut 11 None (open hole)		6 Wire wrapped 9 Drilled holes			
2 Louvered shutter 4 Key punched 7 Torch cut 10 Other (specify) .....					
<b>SCREEN-PERFORATED INTERVALS:</b> From <u>154</u> ft. to <u>164</u> ft. From ..... ft. to ..... ft.					
From ..... ft. to ..... ft. From ..... ft. to ..... ft.					
<b>GRAVEL PACK INTERVALS:</b> From <u>152</u> ft. to <u>171</u> ft. From ..... ft. to ..... ft.					
From ..... ft. to ..... ft. From ..... ft. to ..... ft.					
<b>6 GROUT MATERIAL:</b> 1 Neat cement 2 Cement grout <u>3 Bentonite</u> 4 Other <u>Bentonite Holeplug</u>					
Grout Intervals: From ..... ft. to ..... ft. From ..... ft. to ..... ft. From <u>0</u> ft. to <u>152</u> ft.					
What is the nearest source of possible contamination:					
1 Septic tank 4 Lateral lines 7 Pit privy 10 Livestock pens 14 Abandoned water well		11 Fuel storage 15 Oil well/Gas well			
2 Sewer lines 5 Cess pool 8 Sewage lagoon 12 Fertilizer storage 16 Other (specify below)					
3 Watertight sewer lines 6 Seepage pit 9 Feedyard 13 Insecticide storage <u>None known</u>					
Direction from well? How many feet?					
FROM	TO	LITHOLOGIC LOG	FROM	TO	PLUGGING INTERVALS
0	3	Topsoil			
3	7	Clay, dark brown			
7	12	Clay, brown			
12	28	Sand and gravel, fine, medium, coarse, clean, loose			
28	36	Clay, gray			
36	39	Sand, fine with clay, gray mixed			
39	60	Clay, gray			
60	68	Sand, fine, medium			
68	80	Clay, gray			
80	90	Sand, fine, dirty			
90	118	Sand and gravel, fine, medium			
118	146	Clay, gray			
146	171	Sand and gravel, fine, medium			
171		Clay, green			
<b>7 CONTRACTOR'S OR LANDOWNER'S CERTIFICATION:</b> This water well was (1) <u>constructed</u> , (2) reconstructed, or (3) plugged under my jurisdiction and was completed on (mo/day/year) <u>5-12-97</u> and this record is true to the best of my knowledge and belief. Kansas Water Well Contractor's License No. <u>185</u> This Water Well Record was completed on (mo/day/yr) <u>5-30-97</u> under the business name of <u>Clarke Well &amp; Equipment, Inc.</u> by (signature) <u>Clarke W. Clarke</u>					
INSTRUCTIONS: Use typewriter or ball point pen. PLEASE PRESS FIRMLY and PRINT clearly. Please fill in blanks, underline or circle the correct answers. Send top three copies to Kansas Department of Health and Environment, Bureau of Water, Topeka, Kansas 66620-0001. Telephone: 913-296-5545. Send one to WATER WELL OWNER and retain one for your records.					

# CLARKE WELL & EQUIPMENT, INC.

## WELL RECORD DESIGN & CONSTRUCTION SHEET



JOB NUMBER 3679  
 WELL OWNER City of Wichita WELL NO. H5  
 WELL USE Piezometer APPROPRIATION NO.           
 LOCATION SE 1/4 SE 1/4 SW 1/4, SECTION NO. 29  
 T 23 S, R 2 W E Harvey COUNTY Kansas  
195 FSL, 2936 FEL State

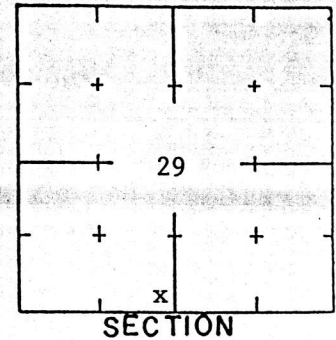

SIZE HOLE 6 "DIA.  
 SIZE CASING 2 " DIA. .218 WALL; WT. .96 LBS/FT PVC MATERIAL  
 SIZE SCREEN 2 " DIA. .218 WALL PVC MATERIAL .030 M11 SLOT/HOLE

FORMATION LOG. From test no. from to			Formation Thickness	From ground level	From	To	Ftg.
0	3	Topsoil		Casing	0	154	154
3	7	Clay, dark brown		Screen	154	164	10
7	12	Clay, brown					
12	28	Sand and gravel, fine, medium, coarse, clean, loose					
28	36	Clay, gray					
36	39	Sand, fine with clay, gray mixed					
39	60	Clay, gray					
60	68	Sand, fine, medium					
68	80	Clay, gray					
80	90	Sand, fine, dirty					
90	118	Sand and gravel, fine, medium					
118	146	Clay, gray					
146	171	Sand and gravel, fine, medium					
171		Clay, green					
				CASING LEFT ABOVE GROUND			2
				TOTAL CASING & SCREEN			166

STATIC WATER LEVEL 50.50 CHLORINATE none QUANTITY USED  
 From ground level

GRAVEL PACK ANNULAR SEAL  
152 TO 171 0 TO 152 Bentonite Holeplug  
         TO                   TO         

WHAT IS THE NEAREST SOURCE OF POSSIBLE CONTAMINATION None known  
 DIRECTION FROM WELL          HOW MANY FEET           
 DESIGNED BY          DRILLED BY Maurice Schreck DATE 5-12-97