

1 LOCATION OF WATER WELL:		Fraction		Section Number		Township Number		Range Number	
County:	Harvey	SE 1/4	NE 1/4	NE 1/4	3	T 23	S	R 2	E 10


Distance and direction from nearest town or city street address of well if located within city?

4 1/2 mi N of Halstead

2] WATER WELL OWNER: John Benewat
RR#, St. Address, Box # : Rt 1
City, State, ZIP Code : Halstead, KS 67056

3 LOCATE WELL'S LOCATION WITH AN "X" IN SECTION BOX: 4 DEPTH OF COMPLETED WELL 84 ft. ELEVATION: 79

WELL'S STATIC WATER LEVEL ... 24 ... ft. below land surface measured on mo/day/yr 8-3-89

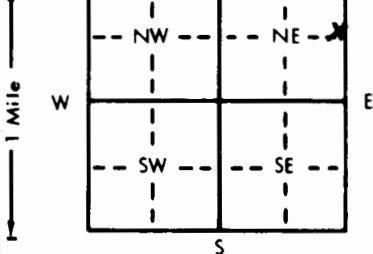

Pump test data: Well water was 80 ft. after 1 hours pumping 2 gpm
Est. Yield 2 gpm: Well water was _____ ft. after _____ hours pumping _____ gpm
Bore Hole Diameter 9 in. to 85 ft., and _____ in. to _____ ft.

WELL WATER TO BE USED AS:

☒ Domestic	☐ 3 Feedlot	☐ 6 Oil field water supply	☐ 9 Dewatering	☐ 11 Injection well
☐ 2 Irrigation	☐ 4 Industrial	☐ 7 Lawn and garden only	☐ 10 Monitoring well	☐ 12 Other (Specify below)

Was a chemical/bacteriological sample submitted to Department? Yes.....No.....☒; If yes, mo/day/yr sample was sub-
mitted _____ Water Well Disinfected? Yes ☒ No _____

5	TYPE OF BLANK CASING USED:		5 Wrought iron	8 Concrete tile	CASING JOINTS: Glued . . . ☒ . . . Clamped Welded Threaded
	1 Steel	3 RMP (SR)	6 Asbestos-Cement	9 Other (specify below)	
	☒ PVC	4 ABS	7 Fiberglass		

Blank casing diameter 5 in. to 69 ft., Dia in. to ft., Dia in. to ft.
Casing height above land surface 12 in. weight lbs./ft. Wall thickness or gauge No. 160

TYPE OF SCREEN OR PERFORATION MATERIAL:					7 PVC	10 Asbestos-cement
1 Steel	3 Stainless steel	5 Fiberglass	8 RMP (SR)	11 Other (specify)		
2 Brass	4 Galvanized steel	6 Concrete tile	9 ABS	12 None used (open hole)		

SCREEN OR PERFORATION OPENINGS ARE:

1 Continuous slot	3 Mill slot	5 Gauzed wrapped	8 Saw cut	11 None (open hole)
2 Louvered shutter	4 Key punched	6 Wire wrapped	9 Drilled holes	
		7 Torch cut	10 Other (specify)	

SCREEN-PERFORATED INTERVALS:	From 69	ft. to 84	ft. From	ft. to	ft.
	From	ft. to	ft. From	ft. to	ft.
GRAVEL PACK INTERVALS:	From 60	ft. to 85	ft. From 23	ft. to 55	ft.
	From	ft. to	ft. From	ft. to	ft.

GROUT MATERIAL:		1 Neat cement	2 Cement grout	3 Bentonite	4 Other
Grout Intervals:	From	3 ft to 23 ft	From	55 ft to 60 ft	From

What is the nearest source of possible contamination:

1 Septic tank	4 Lateral lines	7 Pit privy	10 <u>Livestock pens</u>	14 Abandoned water well
2 Sewer lines	5 Cess pool	8 Sewage lagoon	11 Fuel storage	15 Oil well/Gas well
3 Watertight sewer lines	6 Seepage pit	9 Feedyard	12 Fertilizer storage	16 Other (specify below)
			13 Insecticide storage	

Direction from well? S How many feet? 120

[illegible]

7 CONTRACTOR'S OR LANDOWNER'S CERTIFICATION: This water well was 1 constructed, (2) reconstructed, or (3) plugged under my jurisdiction and was completed on (mo/day/year) 8-3-89 and this record is true to the best of my knowledge and belief. Kansas Water Well Contractor's License No. 447 This Water Well Record was completed on (mo/day/yr) 12-24-89 under the business name of Miller Drilling by (signature) [Signature]