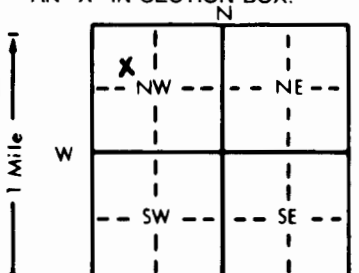


1 LOCATION OF WATER WELL: County: Harvey	Fraction SC 1/4 NW 1/4 NW 1/4	Section Number 13	Township Number T 23 S	Range Number R 2 E
--	---	-----------------------------	----------------------------------	------------------------------

Distance and direction from nearest town or city street address of well if located within city?

2 WATER WELL OWNER: Robert N. Keller RR#, St. Address, Box #: RR #1 Box 26 City, State, ZIP Code: Halstead, KS 67056	EBWQA 8664 Board of Agriculture, Division of Water Resources Application Number:
---	---

3 LOCATE WELL'S LOCATION WITH AN "X" IN SECTION BOX: 	4 DEPTH OF COMPLETED WELL: 62 ft. ELEVATION: Depth(s) Groundwater Encountered: 1 ft. 2. ft. 3. ft. WELL'S STATIC WATER LEVEL: 20 ft. below land surface measured on mo/day/yr Pump test data: Well water was ft. after hours pumping gpm Est. Yield gpm: Well water was ft. after hours pumping gpm Bore Hole Diameter: in. to ft. and in. to ft. WELL WATER TO BE USED AS: 1 Domestic 3 Feedlot 6 Oil field water supply 9 Dewatering 12 Other (Specify below) 2 Irrigation 4 Industrial 7 Lawn and garden only 10 Monitoring well Was a chemical/bacteriological sample submitted to Department? Yes No; If yes, mo/day/yr sample was submitted Water Well Disinfected? Yes No
--	--

5 TYPE OF BLANK CASING USED: 1 Steel 3 RMP (SR) 2 PVC 4 ABS Blank casing diameter: 5 in. to ft. Dia. in. to ft. Dia. in. to ft. Casing height above land surface: 48 in. weight lbs./ft. Wall thickness or gauge No. TYPE OF SCREEN OR PERFORATION MATERIAL: 1 Steel 3 Stainless steel 5 Fiberglass 7 PVC 10 Asbestos-cement 2 Brass 4 Galvanized steel 6 Concrete tile 8 RMP (SR) 11 Other (specify) NA 9 ABS 12 None used (open hole) SCREEN OR PERFORATION OPENINGS ARE: 1 Continuous slot 3 Mill slot 5 Gauzed wrapped 8 Saw cut 11 None (open hole) 2 Louvered shutter 4 Key punched 6 Wire wrapped 9 Drilled holes 7 Torch cut 10 Other (specify) NA SCREEN-PERFORATED INTERVALS: From NA ft. to NA ft. From ft. to ft. GRAVEL PACK INTERVALS: From ft. to ft. From ft. to ft.
--

6 GROUT MATERIAL: 1 Neat cement 2 Cement grout 3 Bentonite 4 Other Grout Intervals: From 20 ft. to 4 ft. From ft. to ft. From ft. to ft. What is the nearest source of possible contamination: 1 Septic tank 4 Lateral lines 7 Pit privy 10 Livestock pens 14 Abandoned water well 2 Sewer lines 5 Cess pool 8 Sewage lagoon 11 Fuel storage 15 Oil well/Gas well 3 Watertight sewer lines 6 Seepage pit 9 Feedyard 12 Fertilizer storage 16 Other (specify below) 13 Insecticide storage Direction from well? How many feet? 150 yds

FROM	TO	LITHOLOGIC LOG	FROM	TO	PLUGGING INTERVALS
			62	20	Chlorinated Sand
			20	4	Bentonite
			4	0	Topsoil

7 CONTRACTOR'S OR LANDOWNER'S CERTIFICATION: This water well was (1) constructed, (2) reconstructed, or (3) plugged under my jurisdiction and was completed on (mo/day/year) 6-21-93 and this record is true to the best of my knowledge and belief. Kansas Water Well Contractor's License No. 6-22-93 This Water Well Record was completed on (mo/day/yr) 6-22-93 under the business name of Robert N. Keller by (signature) Robert N. Keller
--