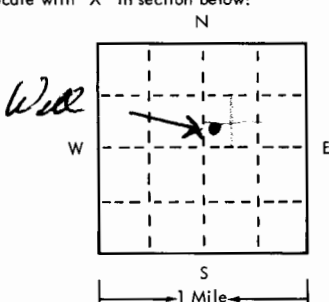


USE TYPEWRITER OR BALL
POINT PEN-PRESS FIRMLY,
PRINT CLEARLY.

WATER WELL RECORD
KSA 82a-1201-1215

T R EW sec 1/4 1/4 1/4 No.

Kansas State Dept. Of Health
(Water Well Contractors)
Forbes-Bldg. 740
Topeka, Kansas 66620

1 Location of well:	County HARVEY	Township name HALSTEAD	Fraction NE 1/4	Section number 15	Town number 23	Range number 2 W
Distance and direction from nearest town or city: 3 No. HALSTEAD			3 Owner of well: ROBERT UNKLEH			
Street address of well location if in city:			Address: RR HALSTEAD			
Locate with "X" in section below: 			Sketch map:			4 Well depth: 52 ft. Date of completion 8-15-75 Well diameter 24 in.
2 Type and color of material			From		To	
			Top soil		0	3
			DARK CLAY		3	8
			SANDY CLAYS - GREY		8	29
			SAND + CLAY MIXED		29	31
CORASE SAND + GRAVEL		31	51			
PINK CLAY		31	52			
CASED WELL to 52 ft.						
CLAYS to 102 1/2 FT.						
ON TEST WELL						
102 1/2 ft is Green Shale						
(use a second sheet if needed)						
16 Remarks: elevation						
Topography: <input type="checkbox"/> Hill <input type="checkbox"/> Slope <input type="checkbox"/> Upland <input checked="" type="checkbox"/> Valley						
FLAT LOW LAND						
					5 <input type="checkbox"/> Cable tool <input type="checkbox"/> Rotary <input type="checkbox"/> Driven <input type="checkbox"/> Dug <input type="checkbox"/> Hollow rod <input type="checkbox"/> Jetted <input type="checkbox"/> Bored <input checked="" type="checkbox"/> Reverse rotary	
					6 Use: <input type="checkbox"/> Domestic <input type="checkbox"/> Public supply <input type="checkbox"/> Industry <input checked="" type="checkbox"/> Irrigation <input type="checkbox"/> Air conditioning <input type="checkbox"/> Commercial <input type="checkbox"/> Test well	
					7 Casing: Material PVC Height: above/below Threaded <input type="checkbox"/> Welded <input checked="" type="checkbox"/> Surface 20 in. Diam. _____ Weight _____ lbs./ft. _____ 10 in. to 52 ft. depth Drive shoe? <input type="checkbox"/> Yes <input type="checkbox"/> No _____ in. to _____ ft. depth	
					8 Screen: Manufacturer CERTAIN TEEB Type P.V.C Dia. 10" Slot/gauze 1/8 Length 20 Set between 32 ft. and 52 ft. Fittings: Gravel pack <input checked="" type="checkbox"/> Yes <input type="checkbox"/> No Size range of material 4"	
					9 Static water level: 12 ft. below land surface Date 8-15-75	
					10 Pumping level below land surfaces: 28 ft. after 2 hrs. pumping 450 g.p.m. _____ ft. after _____ hrs. pumping _____ g.p.m. Estimated maximum yield 450 g.p.m.	
					11 Water sample submitted: <input type="checkbox"/> Yes <input checked="" type="checkbox"/> No Date _____	
					12 Well head completion: <input type="checkbox"/> Pitless adapter 20 inches above grade	
					13 Well grouted? <input checked="" type="checkbox"/> Yes <input type="checkbox"/> No <input type="checkbox"/> Neat cement <input type="checkbox"/> Bentonite <input checked="" type="checkbox"/> PURIFIED CLAY Depth: From 0 ft. to 15 ft.	
					14 Nearest source of possible contamination: ft. 1500 Direction East Type Well Well disinfected upon completion? <input type="checkbox"/> Yes <input checked="" type="checkbox"/> No	
					15 Pump: <input type="checkbox"/> Not installed Manufacturer's name WESTERN LAND ROLLER Model number 4M HP 20 Volts _____ Length of drop pipe 49 ft. capacity 450 g.p.m. Type: <input type="checkbox"/> Submersible <input checked="" type="checkbox"/> Turbine <input type="checkbox"/> Jet <input type="checkbox"/> Reciprocating <input type="checkbox"/> Centrifugal <input type="checkbox"/> Other	
17 Water well contractor's certification: This well was drilled under my jurisdiction and this report is true to the best of my knowledge and belief. PETERSON PROS INC 198 Business name License No. _____ Address LINDBORGE KANSAS Signed Harry Peterson Date 9-10-75 Authorized representative						