USE TYPEWRITER OR BALL POINT PEN-PRESS FIRMLY, PRINT CLEARLY.

WATER WELL RECORD
KSA 82a-1201-1215

Kansas Department of Health and Environment-Division of Environment
(Water well Contractors)
Topeka, Kansas 66620

Loc.

1. Location of well:	County	fraction	Section number	Township number	Range number
	HARVEY	SE 1/4 NW 1/4 SE 1/4	17	T - 23 - S	R - 2 - E/W

2. Distance and direction from nearest town or city: 3½ - 4 N of Halstead
Street address of well location if in city:

3. Owner of well: Clarence Schrier
R.R. or street: RR I
City, state, zip code: Halstead Ks. 67056

X Locate with "X" in section below:

Sketch map:

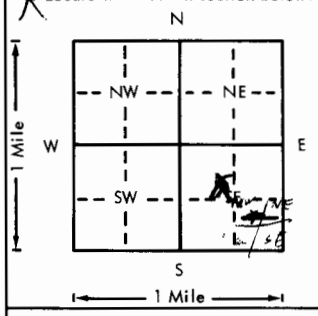

6. Bore hole dia. 4 in. Completion date 1-3-78
Well depth 105 ft.

7. ___ Cable tool X Rotary ___ Driven ___ Dug
___ Hollow rod ___ Jetted ___ Bored ___ Reverse rotary

8. Use: X Domestic ___ Public supply ___ Industry
___ Irrigation ___ Air conditioning ___ Stock
___ Lawn ___ Oil field water ___ Other

9. Casing: Material ___ Height: (Above) or below
Threaded ___ Welded X Surface 12 in.
RMP ___ PVC X Weight 1¼ lbs./ft.
Dia. 4 in. to 105 MLS ft. depth Wall Thickness: inches or
Dia. ___ in. to ___ ft. depth gage No. 1/4

5. Type and color of material	From	To
Top soil	0	5
Fine red sand	5	10
Buff clay	10	25
Grey clay	25	40
Brown clay	40	50
Fine grey sand	50	60
Green clay	60	70
Fine brown sand	70	80
Green + grey clay	80	95
Fine + med. brown sand	95	105
(Use a second sheet if needed)		

10. Screen: Manufacturer's name Peerless Plastics
Type PVC Dia. 4"
Slot/gauze 1/32" Length 15'
Set between 85 ft. and 100 ft.
___ ft. and ___ ft.
Gravel pack? Yes Size range of material 1/4

11. Static water level: mo./day/yr.
22 ft. below land surface Date 1-3-78

12. Pumping level below land surfaces:
25 ft. after 3 hrs. pumping 15 g.p.m.
___ ft. after ___ hrs. pumping ___ g.p.m.
Estimated maximum yield 20 g.p.m.

13. Water sample submitted: mo./day/yr.
___ Yes X No Date ___

14. Well head completion:
X Pitless adapter ___ Inches above grade

15. Well grouted? Yes
With: X Neat cement ___ Bentonite ___ Concrete
Depth: From 4 ft. to 14 ft.

16. Nearest source of possible contamination:
ft. 10000 Direction North Type cattle
Well disinfected upon completion? X Yes ___ No

17. Pump: X Not installed
Manufacturer's name ___
Model number ___ HP ___ Volts ___
Length of drop pipe ___ ft. capacity ___ g.p.m.
Type:
___ Submersible ___ Turbine
___ Jet ___ Reciprocating
___ Centrifugal ___ Other

18. Elevation:

Topography:
___ Hill
___ Slope
___ Upland
___ Valley

19. Remarks:

20. Water well contractor's certification:
This well was drilled under my jurisdiction and this report is true to the best of my knowledge and belief.
Peterson Irrigation 138A
Business name License No.
Address Box 150 Lindsborg Ks.
Signed Mike Chambers Date 1-11-78
Authorized representative

T 23 R 2 E/W Sec 17 SE¼ NW¼ SE¼

Forward the white, blue and pink copies to the Department of Health and Environment

Form WWC-5