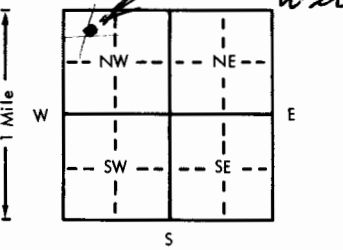


1. Location of well: <u>Harvey</u> County: <u>Harvey</u>		Fraction: <u>1/4 NW 1/4 NW 1/4</u>		Section number: <u>18</u>		Township number: <u>T 23</u>		Range number: <u>R 2</u>	
2. Distance and direction from nearest town or city: <u>4 W. West</u> Street address of well location if in city: <u>400. Halstead</u> <u>Kanson</u>					3. Owner of well: <u>JOHN E EWY</u> R.R. or street: <u>RR</u> City, state, zip code: <u>HALSTEAD KANS 67056</u>				
4. Locate with "X" in section below:  Sketch map:					6. Bore hole dia. <u>18</u> in. Completion date <u>11-18-76</u> Well depth <u>32</u> ft.				
5. Type and color of material					7. <input checked="" type="checkbox"/> Cable tool <input checked="" type="checkbox"/> Rotary <input type="checkbox"/> Driven <input type="checkbox"/> Dug <input type="checkbox"/> Hollow rod <input type="checkbox"/> Jetted <input type="checkbox"/> Bored <input type="checkbox"/> Reverse rotary				
					8. Use: <input checked="" type="checkbox"/> Domestic <input type="checkbox"/> Public supply <input type="checkbox"/> Industry <input type="checkbox"/> Irrigation <input type="checkbox"/> Air conditioning <input type="checkbox"/> Stock <input type="checkbox"/> Lawn <input type="checkbox"/> Oil field water <input type="checkbox"/> Other				
					9. Casing: Material <u>PVC</u> Height: Above or below Threaded <input type="checkbox"/> Welded <input checked="" type="checkbox"/> Surface <u>18</u> in. RMP <input type="checkbox"/> PVC <input checked="" type="checkbox"/> Weight <u>2</u> lbs./ft. Dia. <u>4</u> in. to <u>32</u> ft. depth Wall Thickness: inches or Dia. <u>  </u> in. to <u>  </u> ft. depth gage No. <u>3/4</u>				
					10. Screen: Manufacturer's name <u>CERTIFIED</u> Type <u>PVC</u> Dia. <u>  </u> Slot/gauze <u>1/8</u> Length <u>10</u> Set between <u>22</u> ft. and <u>32</u> ft. _____ ft. and _____ ft. Gravel pack? <u>yes</u> Size range of material <u>24"</u>				
11. Static water level: _____ mo./day/yr. <u>7</u> ft. below land surface Date <u>11-18-76</u>					12. Pumping level below land surfaces: <u>14</u> ft. after <u>1</u> hrs. pumping <u>15</u> g.p.m. _____ ft. after _____ hrs. pumping _____ g.p.m. Estimated maximum yield <u>25</u> g.p.m.				
					13. Water sample submitted: _____ mo./day/yr. Yes <input type="checkbox"/> No <input checked="" type="checkbox"/> Date _____				
					14. Well head completion: <u>no</u> Pitless adapter _____ Inches above grade				
					15. Well grouted? <u>yes</u> With: <input checked="" type="checkbox"/> Neat cement <input type="checkbox"/> Bentonite <input type="checkbox"/> Concrete Depth: From <u>0</u> ft. to <u>10</u> ft.				
16. Nearest source of possible contamination: <u>SEPTIC</u> <u>75</u> ft. Direction <u>NE</u> Type <u>drain</u> Well disinfected upon completion? <input checked="" type="checkbox"/> Yes <input type="checkbox"/> No					17. Pump: <input checked="" type="checkbox"/> Not installed Manufacturer's name _____ Model number _____ HP _____ Volts _____ Length of drop pipe _____ ft. capacity _____ g.p.m. Type: <input type="checkbox"/> Submersible <input type="checkbox"/> Turbine <input type="checkbox"/> Jet <input type="checkbox"/> Reciprocating <input type="checkbox"/> Centrifugal <input type="checkbox"/> Other				
					18. Elevation: _____				
					19. Remarks: _____				
					20. Water well contractor's certification: This well was drilled under my jurisdiction and this report is true to the best of my knowledge and belief. <u>Peterson Irrigation</u> <u>138A</u> Business name License No. Address <u>Box 150 Linwood, KS</u> Signed <u>William Peterson</u> Date <u>12-8-76</u> Authorized representative				