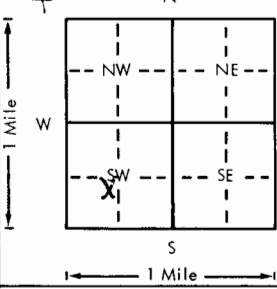
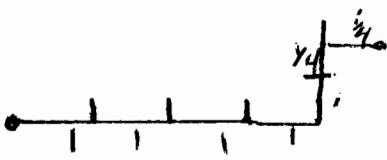


USE TYPEWRITER OR BALL
POINT PEN-PRESS FIRMLY,
PRINT CLEARLY.

WATER WELL RECORD
KSA 82a-1201-1215

Kansas Department of Health and
Environment-Division of Environment
(Water well Contractors)
Topeka, Kansas 66620

1. Location of well:	County Harvey	Fraction SW 1/4 NE 1/4 SW 1/4	Section number 18	Township number T 23S S R 2 W E/W	Range number
2. Distance and direction from nearest town or city: 4 MI. East of Burrton, Street address of well location if in city: 1 1/4 N. 1/4 East in field		3. Owner of well: Blackstone Drilling Inc. R.R. or street: P.O. Box 1184 City, state, zip code: McPherson, Kansas			
4. Locate with "X" in section below: 		Sketch map: 		6. Bore hole dia. 6 in. Completion date 6/20/79 Well depth 100 ft.	
5. Type and color of material		From	To	7. <input type="checkbox"/> Cable tool <input checked="" type="checkbox"/> Rotary <input type="checkbox"/> Driven <input type="checkbox"/> Dug <input type="checkbox"/> Hollow rod <input type="checkbox"/> Jetted <input type="checkbox"/> Bored <input type="checkbox"/> Reverse rotary	
				8. Use: <input type="checkbox"/> Domestic <input type="checkbox"/> Public supply <input type="checkbox"/> Industry <input type="checkbox"/> Irrigation <input type="checkbox"/> Air conditioning <input type="checkbox"/> Stock <input type="checkbox"/> Lawn <input checked="" type="checkbox"/> Oil field water <input type="checkbox"/> Other	
				9. Casing: Material Plastic Height: Above or below Threaded <input type="checkbox"/> Welded <input type="checkbox"/> Surface 18 in. RMP <input type="checkbox"/> PVC <input checked="" type="checkbox"/> Weight <input type="checkbox"/> lbs./ft. Dia. 3 in. to 6 ft. depth Wall Thickness: inches or Dia. 19 in. to 30 ft. depth gage No. 372 210	
				10. Screen: Manufacturer's name Certain Teed Type sawed Dia. 3 Slot/gauze 4 Length 20 Set between 80 ft. and 100 ft. ft. and 100 ft. Gravel pack? yes Size range of material 1/8-1/2	
				11. Static water level: 32 ft. below land surface Date 6/20/79 mo./day/yr.	
				12. Pumping level below land surfaces: 35 ft. after 1 hrs. pumping 30 g.p.m. ft. after 1 hrs. pumping 30 g.p.m. Estimated maximum yield 30 g.p.m.	
				13. Water sample submitted: Yes <input checked="" type="checkbox"/> No <input type="checkbox"/> Date 6/20/79 mo./day/yr.	
				14. Well head completion: 18 inches above grade <input type="checkbox"/> Pitless adapter	
				15. Well grouted? yes With: <input checked="" type="checkbox"/> Neat cement <input type="checkbox"/> Bentonite <input type="checkbox"/> Concrete Depth: From 0 ft. to 10 ft.	
				16. Nearest source of possible contamination: ft. None Direction None Type None Well disinfected upon completion? <input type="checkbox"/> Yes <input checked="" type="checkbox"/> No	
				17. Pump: <input checked="" type="checkbox"/> Not installed Manufacturer's name Not installed Model number Not installed HP Not installed Volts Not installed Length of drop pipe Not installed ft. capacity Not installed g.p.m. Type: <input type="checkbox"/> Submersible <input type="checkbox"/> Turbine <input type="checkbox"/> Jet <input type="checkbox"/> Reciprocating <input type="checkbox"/> Centrifugal <input type="checkbox"/> Other	
18. Elevation:		19. Remarks:		20. Water well contractor's certification: This well was drilled under my jurisdiction and this report is true to the best of my knowledge and belief. Rosencrantz-Bemis Ent. Inc. Business name License No. 1211 W. 4th Hutchinson, Ks. Address Mike Rowe Date 6/22/79 Signed Authorized representative	