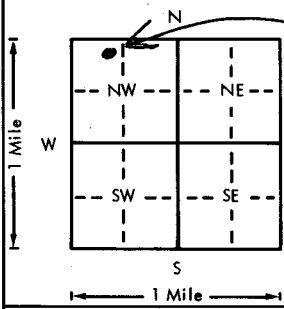



USE TYPEWRITER OR BALL  
POINT PEN. PRESS FIRMLY.  
PRINT CLEARLY.

WATER WELL RECORD  
KSA 82a-1201-1215

Kansas Department of Health and  
Environment-Division of Environment  
(Water well Contractors)  
Topeka, Kansas 66620

1. Location of well: <u>Harvey</u>		County: <u>Harvey</u>	Fraction: <u>1/4 NW 1/4 NW 1/4</u>	Section number: <u>22</u>	Township number: <u>T 23 S</u>	Range number: <u>R 2 E</u>
2. Distance and direction from nearest town or city: <u>2 West</u>			3. Owner of well: <u>WILFORD HOLDERMAN</u>			
Street address of well location if in city: <u>2 NO. Halstead, Ks</u>			City, state, zip code: <u>HALSTEAD, KANSAS 67052</u>			
4. Locate with "X" in section below:			Sketch map:			
						
5. Type and color of material			From	To	6. Bore hole dia. <u>8</u> in. Completion date <u>12-17-76</u>	
Top Soil			0	5	Well depth <u>62</u> ft.	
CLAY-BUFF			5	16	7. <input checked="" type="checkbox"/> Cable tool <input checked="" type="checkbox"/> Rotary <input type="checkbox"/> Driven <input type="checkbox"/> Dug	
CLAY-GREY-SANDY			16	34	<input type="checkbox"/> Hollow rod <input type="checkbox"/> Jetted <input type="checkbox"/> Bored <input type="checkbox"/> Reverse rotary	
SAND-FINE			34	42	8. Use: <input checked="" type="checkbox"/> Domestic <input type="checkbox"/> Public supply <input type="checkbox"/> Industry	
SAND-MED. to COARSE			42	62	<input type="checkbox"/> Irrigation <input type="checkbox"/> Air conditioning <input type="checkbox"/> Stock	
Cased 62 ft.					<input type="checkbox"/> Lawn <input type="checkbox"/> Oil field water <input type="checkbox"/> Other	
					9. Casing: Material <u>PVC</u> Height: Above or below	
					Threaded <input type="checkbox"/> Welded <input checked="" type="checkbox"/> Surface <u>24</u> in.	
					RMP <input type="checkbox"/> PVC <input checked="" type="checkbox"/> Weight <u>21</u> lbs./ft.	
					Dia. <u>4</u> in. to <u>62</u> ft. depth Wall Thickness: inches or	
					Dia. <u>4</u> in. to <u>62</u> ft. depth gage No. <u>214</u>	
					10. Screen: Manufacturer's name <u>CESTANTRIP</u>	
					Type <u>PVC</u> Dia. <u>4"</u>	
					Slot/gauze <u>1/8</u> Length <u>10</u>	
					Set between <u>52</u> ft. and <u>62</u> ft.	
					Gravel pack? <u>Yes</u> Size range of material <u>24"</u>	
					11. Static water level: <u>15</u> ft. below land surface Date <u>11-22-76</u>	
					12. Pumping level below land surfaces:	
					<u>30</u> ft. after <u>2</u> hrs. pumping <u>10</u> g.p.m.	
					<u>   </u> ft. after <u>   </u> hrs. pumping <u>   </u> g.p.m.	
					Estimated maximum yield <u>25</u> g.p.m.	
					13. Water sample submitted: <u>   </u> mo./day/yr.	
					Yes <input checked="" type="checkbox"/> No <input type="checkbox"/> Date <u>   </u>	
					14. Well head completion: <u>NO</u>	
					<u>   </u> Pitless adapter <u>   </u> Inches above grade	
					15. Well grouted? <u>Yes</u>	
					With: <input checked="" type="checkbox"/> Neat cement <input type="checkbox"/> Bentonite <input type="checkbox"/> Concrete	
					Depth: From <u>0</u> ft. to <u>10</u> ft.	
					16. Nearest source of possible contamination: <u>LATERAL</u>	
					ft. <u>55</u> Direction <u>SE</u> Type <u>LATERAL</u>	
					Well disinfected upon completion? <input checked="" type="checkbox"/> Yes <input type="checkbox"/> No	
					17. Pump: <input checked="" type="checkbox"/> Not installed	
					Manufacturer's name <u>   </u>	
					Model number <u>   </u> HP <u>   </u> Volts <u>   </u>	
					Length of drop pipe <u>   </u> ft. capacity <u>   </u> g.p.m.	
					Type:	
					<input type="checkbox"/> Submersible <input type="checkbox"/> Turbine	
					<input type="checkbox"/> Jet <input type="checkbox"/> Reciprocating	
					<input type="checkbox"/> Centrifugal <input type="checkbox"/> Other	
18. Elevation:			20. Water well contractor's certification:			
Topography:			This well was drilled under my jurisdiction and this report			
<input type="checkbox"/> Hill			is true to the best of my knowledge and belief.			
<input type="checkbox"/> Slope			<u>PETERSON BROS INC</u> <u>138A</u>			
<input checked="" type="checkbox"/> Upland			Business name <u>   </u> License No. <u>   </u>			
<input type="checkbox"/> Valley			Address <u>BOX 150 LIPSA, KS</u>			
			Signed <u>William H. Peterson</u> Date <u>12-8-76</u>			
			Authorized representative <u>   </u>			